

CLARKE

MISSISSIPPI BOARD OF WATER COMMISSIONERS

P6

6-4-65

WATER WELL DRILLERS LOG

CODED

Date June 4, 1965, Driller Carter Drilling Co. County Jasper

(1) Owner of Land:	Description & Color of Materials	Thick-ness Feet	Depth Feet
Mrs. Evelyn McDaniel (Name)	Sand, Clay, Red Clay, Shell, etc.		
Art 1 Vossberg, Miss (Address)	red clay	10	10
SE 1/4, NE 1/4, Sec. 25 T. 1 R. 14E	coarse sand	42	52
4 miles east of Vossberg (distance) (direction) (Nearest Town)	fine gravel	30	82
(3) Topography: hilly (Hilly) (Flat) (Level)	fine gravel & sand		
(4) Purpose of Well: domestic (Domestic Irrigation Municipal, Industrial, Other)	red chalk	10	92
	fine gravel & sand	10	102
	coarse sand	31	133
	stoped white		
	still in sand		

Information upon completion of well:


- (1) Diameter 2" inches.
- (2) Total Depth 133' feet.
- (3) Water Level 111' feet below top of ground.
- (4) Cased to 10.5', Size 2"
- (5) Screen: Size 1 1/4", Length 5'
10 slot Johnson S.S
- (6) Were any formations sealed against pollution?
yes, X no.

If YES depth of formation

Why

Drillers Remarks:

CODED

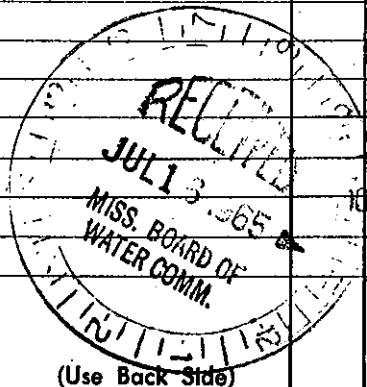

(Use Back Side)

Well No.

Mail this copy to Board of Water Commissioners 429 Miss. St. Jackson, Miss