


SP8  
7-9-60

WATER WELL DRILLERS LOG

P 300<sup>P</sup>

Date: 7-9, 1960, Driller: Peoples & Rutledge County Clarke  
(Name)

(1) Owner of Land: <u>West Bros.</u> (Name)	Description & Color of Materials Sand, Clay, Red Clay, Shell, etc.	Thick- ness Feet	Depth Feet.
<u>Vossberg Rt # 2 Miss</u> (Address)	<u>Sandy Clay</u>	<u>12</u>	<u>12</u>
(2) Location: <u>1/4, 1/4, Sec. 6 T1R14</u> <u>3 miles East</u> of <u>Vossburg</u> (distance) (direction) (Nearest Town) <i>Maple</i>	<u>Iron &amp; Shale</u>	<u>200</u>	<u>212</u>
(3) Topography: <u>Hilly</u> (Hilly) (Flat) (Level)	<u>Fine Grained Block Sand</u>	<u>40</u>	<u>252</u>
(4) Purpose of Well: <u>Domestic</u> (Domestic Irrigation Municipal, Industrial, Other)			
Information upon completion of well:			
(1) Diameter <u>4</u> inches.			
(2) Total Depth <u>252</u> feet.			
(3) Water Level <u>80</u> feet below top of ground.			
(4) Cased to <u>100'</u> , Size <u>4"</u>			
(5) Screen: Size _____, Length _____			
(6) Were any formations sealed against pollution? _____ yes, _____ no.			
If YES depth of formation _____			
Why _____			
Drillers Remarks: _____ _____ _____			

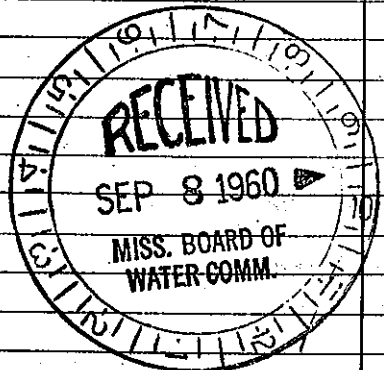

Well No.

(Use Back Side)

Retain this copy for your office files.