

STATE OF MISSOURI DEPARTMENT OF WATER COMMISSIONERS

CLARKE

WATER WELL DRILLERS LOG

6 P 9  
 Date: 8-12-64, 1964, Driller: M. E. Donahue & Hill, Inc. County: Clarke

(Name)

(1) Owner of Land	Description & Color of Materials Sand, Clay, Red Clay, Shell, etc.	Thick- ness Feet	Depth Feet
EMMIT JONES (Name)	CLAY	0	30
R#1 Box 146 Pochuta, Miss (Address)	SHAPE STONE	30	145
(2) Location: 1/4, 1/4, Sec. 18 T. 14 N. R. 4 E	BROWN SHALE & SAND	145	220
10 miles South of Pochuta (distance) (direction) (Nearest Town)	SAND & SHALE	220	250
(3) Topography: <input checked="" type="checkbox"/> (Hilly) <input type="checkbox"/> (Flat) <input type="checkbox"/> (Level)			
(4) Purpose of Well: Domestic (Domestic Irrigation, Municipal, Industrial, Other)			


Information upon completion of well:

- (1) Diameter: 3 1/4 inches TEST HOLE
- (2) Total Depth: 250' feet.
- (3) Water Level: 84' feet below top of ground.
- (4) Cased to 240', Size 2"
- (5) Screen: Size 2", Length 8'
- (6) Were any formations sealed against pollution?  
 \_\_\_\_\_ yes, \_\_\_\_\_ no.

If YES depth of formation \_\_\_\_\_

Why \_\_\_\_\_

Drillers Remarks: WILL NEED 110' DROP PIPE

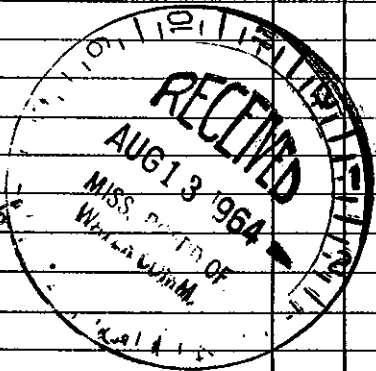

BRASS

Well No.

(Use Back Side)

Retain this copy for your office files.