

CLARKE

6 P 10

6-23-64

MISSISSIPPI BOARD OF WATER COMMISSIONERS

WATER WELL DRILLERS LOG

Date: 6-23, 1964, Driller: M & Donald Hill, Inc. County: Clarke

(Name)

(1) Owner of Land:	Description & Color of Materials Sand, Clay, Red Clay, Shell, etc.	Thick- ness Feet	Depth Feet
Heenan Musley (Name)	Clay	0	20
Rt # 2, Vossburg, Miss (Address)	Oily shale	20	72
Location: 1/4, 1/4, Sec. 10 T R	Sandy & st. lignite	72	140
12 miles S-W, of Qu. Man (distance) (direction) (Nearest Town)	Shaly & st. sand	140	172
(3) Topography: <input checked="" type="checkbox"/> (Hilly) <input type="checkbox"/> (Flat) <input type="checkbox"/> (Level)			
(4) Purpose of Well: Domestic (Domestic Irrigation, Municipal, Industrial, Other)			


Information upon completion of well:

- (1) Diameter 2 inches.
- (2) Total Depth 172 feet.
- (3) Water Level 31 feet below top of ground.
- (4) Cased to 162, Size.
- (5) Screen: Size 2", Length 10'
- (6) Were any formations sealed against pollution?  
yes,  no.

If YES depth of formation

Why

Drillers Remarks:

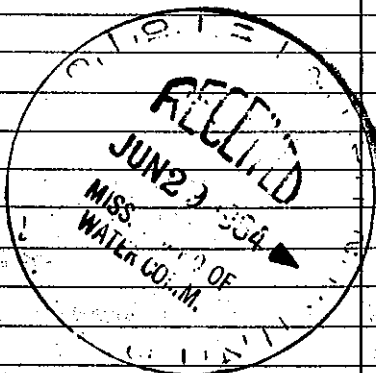

(Use Back Side)

Well No.

Mail this copy to Board of Water Commissioners 429 Miss. St. Jackson, Miss