

CLARKE MISSISSIPPI BOARD OF WATER COMMISSIONERS

6P11
1-14-64

WATER WELL DRILLERS LOG

Date: Jan 14, 1964, Driller: Porter Drilling & Pump County Clarke
(Name) Shayne

| (1) Owner of Land | Description & Color of Materials Sand, Clay, Red Clay, Shell, etc. | Thick- ness Feet | Depth Feet |
|---|---|------------------------|---------------|
| <u>Rutherford Lowery Jr.</u> (Name) | <u>sandy clay</u> | <u>9</u> | <u>9</u> |
| <u>211 Vossberg, Miss</u> (Address) | <u>lower hard to per gravel</u> | <u>31</u> | <u>40</u> |
| (2) Location: <u>1/4</u> , <u>1/4</u> , Sec. <u>9</u> T. <u>11R</u> S. <u>9W</u> | <u>open gravel & sand</u> | <u>8</u> | <u>48</u> |
| <u>4</u> miles <u>NW</u> of <u>Euentsa</u> , (distance) (direction) (Nearest Town) | <u>loam & chaly</u> | <u>12</u> | <u>60</u> |
| (3) Topography: <u>Hilly</u> (Hilly) (Flat) (Level) | <u>chaly & sand</u> | <u>16</u> | <u>76</u> |
| (4) Purpose of Well: <u>domestic</u> (Domestic Irrigation Municipal, Industrial, Other) | <u>med. sand</u> | <u>9</u> | <u>85</u> |


Information upon completion of well:

- (1) Diameter 2' inches.
- (2) Total Depth 85' feet.
- (3) Water Level 56' feet below top of ground.
- (4) Cased to 50', Size 2'
- (5) Screen: Size 1 1/4, Length 5'
- (6) Were any formations sealed against pollution?
Johnson S.S
X yes, X no.

If YES depth of formation _____

Why _____

Drillers Remarks: _____

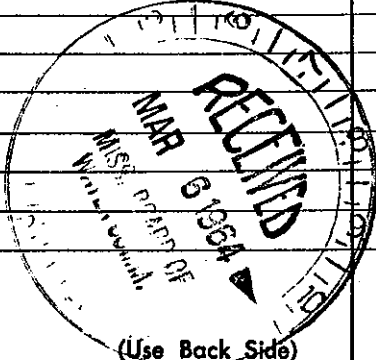

Well No. _____

Mail this copy to Board of Water Commissioners 429 Miss. St. Jackson, Miss