

CLARKE MISSISSIPPI BOARD OF WATER COMMISSIONERS

6 P12
4-23-63

WATER WELL DRILLERS LOG

Mr. Don H. Hill, Jr.

Date: 4-23, 1963, Driller: Lee B. Chatham County, Clarke
(Name)

(1) Owner of Land	Description & Color of Materials Sand, Clay, Red Clay, Shell, etc.	Thick- ness Feet	Depth Feet
Jackson Wall (Name)	Clay	0	20
Washington Miss (Address)	Sand & gravel	20	26
(2) Location: 1/4, 1/4, Sec. 16 T. 14 R.	yellow clay	26	31
4 miles East of Washington (distance) (direction) (Nearest Town)	shale	31	85
(3) Topography: Hilly (Hilly) (Flat) (Level)	shale w/ lime streaks	85	133
(4) Purpose of Well: Domestic (Domestic Irrigation Municipal, Industrial, Other)	soft shale w/ lime	133	170
	soft sand w/ sh. shale	170	180
	Sand	180	220

Information upon completion of well:


- (1) Diameter 3 1/4 inches.
- (2) Total Depth 225 feet.
- (3) Water Level 25 feet below top of ground.
- (4) Cased to 161, Size 4"
- (5) Screen: Size 2", Length 5'
- (6) Were any formations sealed against pollution?
_____ yes, _____ no.

If YES depth of formation _____

Why _____

Drillers Remarks: _____

\$ 75.00

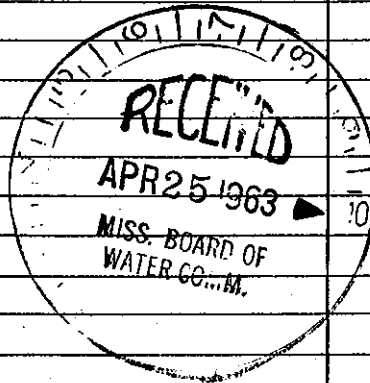

Well No.

(Use Back Side)

Mail this copy to Board of Water Commissioners 429 Miss. St. Jackson, Miss