

CLARKE MISSISSIPPI BOARD OF WATER COMMISSIONERS

6 P 13
9-62

WATER WELL DRILLERS LOG

Date: Sept, 1962, Driller: Peepert & Rutledge County Clarke
(Name)

(1) Owner of Land:	Description & Color of Materials Sand, Clay, Red Clay, Shell, etc.	Thick- ness Feet	Depth Feet
(Name) <u>James Patrick</u>	<u>top to yellow sandy</u>		
(Address) <u>Vossburg Rt 2</u>	<u>clay</u>	<u>12</u>	<u>12</u>
(2) Location: $\frac{1}{4}$, $\frac{1}{4}$, Sec. <u>11</u> T <u>14</u> R	<u>Blue shale</u>	<u>24</u>	<u>36</u>
(distance) <u>11</u> miles <u>SW</u> (direction), of <u>Quitman</u> (Nearest Town)	<u>Gray sand + small</u>		
(3) Topography: <u>Hilly</u> (Hilly) (Level)	<u>shale streaks</u>	<u>48</u>	<u>84</u>
(4) Purpose of Well: <u>Domestic</u> (Domestic Irrigation, Municipal, Industrial, Other)	<u>Gray sandy shale</u>	<u>51</u>	<u>135</u>
	<u>Gray shale</u>	<u>18</u>	<u>153</u>
	<u>green lime + limestone</u>	<u>65</u>	<u>198</u>
	<u>brown shale +</u>		
	<u>sandy shale</u>	<u>27</u>	<u>225</u>
	<u>light brown sand</u>	<u>33</u>	<u>258</u>


Information upon completion of well:

- (1) Diameter 2 inches.
- (2) Total Depth 258 feet.
- (3) Water Level 48 feet below top of ground.
- (4) Cased to 252', Size 2"
- (5) Screen: Size 2", Length 6'
- (6) Were any formations sealed against pollution?
no.

If YES depth of formation _____

Why _____

Drillers Remarks: _____

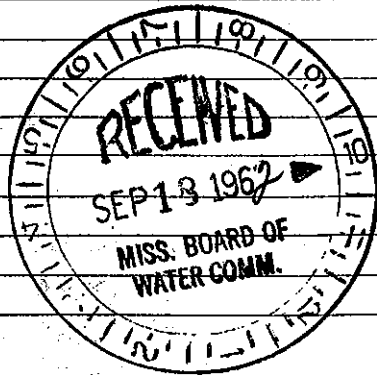

(Use Back Side)

Well No.

Mail this copy to Board of Water Commissioners 429 Miss. St. Jackson, Miss