

CLARKE
6 P 14

MISSISSIPPI BOARD OF WATER COMMISSIONERS

5-4-62

WATER WELL DRILLERS LOG

10

Date: 5/4, 1962, Driller: C.P. Clark County Jones
(Name)

	Description & Color of Materials Sand, Clay, Red Clay, Shell, etc.	Thick- ness Feet	Depth Feet
(1) Owner of Land: <u>Orland Lowrey</u> (Name) <u>RT #2 Heidelberg Miss</u> (Address)	0-16 Red Clay Sandy	16	
(2) Location: $\frac{1}{4}$, $\frac{1}{4}$, Sec. <u>4</u> ^{10N9W} T R	16-104 Sand & gravel	88	
<u>5</u> miles <u>East</u> of <u>Heberg</u> (distance) (direction) (Nearest town)			
(3) Topography: <input checked="" type="checkbox"/> (Hilly) <input type="checkbox"/> (Flat) <input type="checkbox"/> (Level)			
(4) Purpose of Well: _____ (Domestic, Irrigation, Municipal, Industrial, Other)			


Information upon completion of well:

- (1) Diameter 2 inches.
- (2) Total Depth 104 feet.
- (3) Water level 80 feet below top of ground.
- (4) Cased to 99, Size 2.
- (5) Screen: Size 1/4, Length 5.
- (6) Were any formations sealed against pollution?
_____ yes, no.

If YES depth of formation _____

Why _____

Drillers Remarks: _____

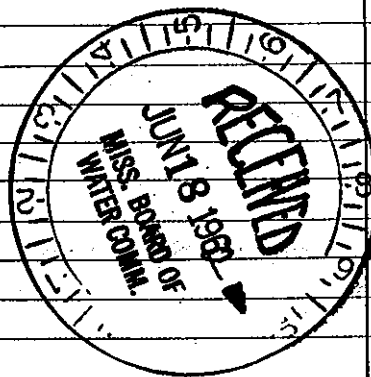

(Use Back Side)

Well No.

Mail this copy to Board of Water Commissioners 429 Miss. St. Jackson, Miss