

Clarke

JASPER

R15

4-68

USGEO

4.9.68

date well completed

MCDONALD + HILL

firm name

CLARKE

JASPER

county well located

MISSISSIPPI  
 BOARD OF WATER COMMISSIONERS  
 416 North State Street  
 Jackson, Mississippi 39201

WATER WELL DRILLERS LOG

LANDOWNER: BEAVER DAM  
STAFFORD SPRINGS

description of formations encountered

from to

(mailing address)

WELL LOCATION:

sec. 05 T. 14 N. R. 13 E.  
3 miles EAST of STAFFORD SPRINGS  
 (distance) (direction) (nearest town)


<u>Sandy Clay</u>	<u>0</u>	<u>18</u>
<u>Sand &amp; Clay</u>	<u>18</u>	<u>140</u>
<u>Gravel</u>	<u>140</u>	<u>155</u>
<u>Shale</u>	<u>155</u>	<u>164</u>
<u>Rock &amp; Shale</u>	<u>164</u>	<u>320</u>
<u>YAZOO CLAY</u>	<u>320</u>	<u>380</u>
<u>Shale</u>	<u>380</u>	<u>452</u>
<u>Sandy</u>	<u>452</u>	<u>462</u>
<u>Shale</u>	<u>462</u>	<u>500</u>
<u>Soft Sandy</u>	<u>500</u>	<u>520</u>
<u>Sandy &amp; Shells</u>	<u>520</u>	<u>540</u>
<u>Shale &amp; Sand</u>	<u>540</u>	<u>574</u>
<u>Rock</u>	<u>574</u>	<u>580</u>
<u>Sand</u>	<u>580</u>	<u>610</u>
<u>Sandy</u>	<u>610</u>	<u>620</u>

WELL PURPOSE:

(home, irrigation, municipal, industrial)

WELL COMPLETION DATA:

- (1) diameter (inches) 3 7/8
- (2) total depth (feet) 620'
- (3) static water level (feet) 230 below top of ground.
- (4) casing BLK 160'  
(material) (depth)  
4" if telescope see back.  
(size)
- (5) screen 10' 590'  
(length) (depth to top)  
2" Galv  
(size) (material)
- (6) pump NO 35  
(HP) (yield gpm)  
NO  
(type power)
- (7) electric log YES  
(yes or no)  
USGEO  
(organization running log)
- (8) how well bottom plugged VALVE

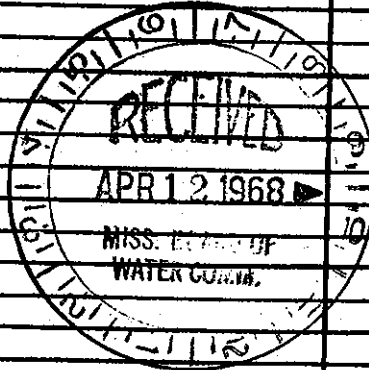

DRILLERS REMARKS: