

MISSISSIPPI DEPARTMENT OF NATURAL RESOURCES

Bureau of Land and Water Resources

Southport Mall

P.O. Box 10631

Jackson, Mississippi 39209

CODED

WATER WELL DRILLERS LOG

Clarke
P 51
4-13-81

4-13-81 date well completed
Griner Drilling Service, Inc. firm name
Clarke county well located


LANDOWNER:
Pruet Production
1515 Capital Towers
Jackson, Ms 39202
(mailing address)

| description of formations encountered | from | to |
|---------------------------------------|------|-----|
| clay & rock | 0 | 114 |
| clay, shell, sand | 114 | 177 |
| sand, clay, rocks | 177 | 366 |
| sand | 366 | 471 |
| clay | 471 | 492 |

WELL LOCATION: ~~SSD 154 2090 10~~
No. 16 T 10 N R 14 E of
Holland Clark Co. line
Jasper Co. line
(distance) (direction) (nearest town)

WELL PURPOSE:
(home, irrigation, municipal, industrial)

- WELL COMPLETION DATA:
- (1) diameter (inches) 4"
 - (2) total depth (feet) 471'
 - (3) static water level (feet) 65' below top of ground
 - (4) casing skel 471' (material) (depth)
4" (size) If telescope see back.
 - (5) screen 42' 429' (length) (depth to top)
4" perforated (size) (material)
 - (6) pump — 95 (HP) (yield gpm)
AC (type power)
 - (7) electric log — (yes or no)
(organization running log)
 - (8) how well bottom plugged orange peel

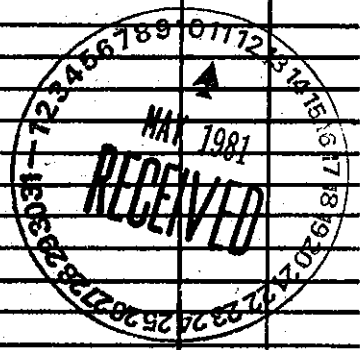

DRILLERS REMARKS: