

CLARKE MISSISSIPPI BOARD OF WATER COMMISSIONERS

3 Q 3

1-22-64

WATER WELL DRILLERS LOG

Date: 1-22, 1964, Driller: McDonald Hill County Clarke
(Name)

(1) Owner of Land: <u>John B Carter</u> (Name)	Description & Color of Materials Sand, Clay, Red Clay, Shell, etc.	Thick- ness Feet	Depth Feet
<u>Shubuta, Miss.</u> (Address)	<u>Clay & Chalk</u>	<u>0</u>	<u>27</u>
(2) Location: <u>1/4, 1/4, Sec. T R</u>	<u>limy shale</u>	<u>27</u>	<u>115</u>
<u>5</u> miles <u>N W</u> , of <u>Shubuta</u> (distance) (direction) (Nearest Town)	<u>light sand lime</u>	<u>115</u>	<u>125</u>
(3) Topography: <u>Hilly</u> (Hilly) (Flat) (Level)	<u>shale w/ red st.</u>	<u>125</u>	<u>128</u>
(4) Purpose of Well: <u>Domestic</u> (Domestic Irrigation Municipal, Industrial, Other)	<u>shale</u>	<u>128</u>	<u>168</u>
	<u>soft sand</u>	<u>168</u>	<u>192</u>
	<u>shale</u>	<u>192</u>	<u>196</u>
	<u>Sand w/ shale break</u>	<u>196</u>	<u>240</u>


Information upon completion of well:

- (1) Diameter 4 inches.
- (2) Total Depth 240 feet.
- (3) Water Level 45 feet below top of ground.
- (4) Cased to 143, Size 4.
- (5) Screen: Size _____, Length _____.
- (6) Were any formations sealed against pollution?
_____ yes, _____ no.

If YES depth of formation _____

Why _____

Drillers Remarks: _____

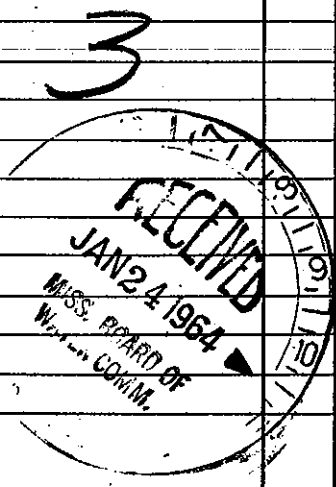

(Use Back Side)

Well No.

Mail this copy to Board of Water Commissioners 429 Miss. St. Jackson, Miss.