

entered

CLARKE  
Q 206  
2-68

MISSISSIPPI  
BOARD OF WATER COMMISSIONERS  
416 North State Street  
Jackson, Mississippi 39201

WATER WELL DRILLERS LOG

2-12-1968 Jerry Drilling Co. Clarke  
date well completed firm name county well located


LANDOWNER:  
Southern Household  
Shubuta, Miss.  
(mailing address)

description of formations encountered	from	to
<u>yellow clay</u>	<u>0</u>	<u>12</u>
<u>coarse sand</u>	<u>12</u>	<u>30</u>
<u>blue dirt &amp; rock</u>	<u>30</u>	<u>90</u>
<u>fine sand</u>	<u>90</u>	<u>121</u>

WELL LOCATION:  
sec 25 T 1 N R 15 E  
3 miles N of Shubuta  
(distance) (direction) (nearest town)

WELL PURPOSE:  
(home, irrigation, municipal, Industrial)

- WELL COMPLETION DATA:
- (1) diameter (inches) 8"
  - (2) total depth (feet) 121'
  - (3) static water level (feet) 19 below top of ground. above
  - (4) casing Black 89'  
(material) (depth)
  - 6 (size) if telescope see back.
  - (5) screen 25' 96'  
(length) (depth to top)
  - 6" Stainless steel  
(size) (material)
  - (6) pump 10 50  
(HP) (yield gpm)
  - Submersible  
(type power)
  - (7) electric log No  
(yes or no)
  - (organization running log)
  - (8) how well bottom plugged crack  
plug

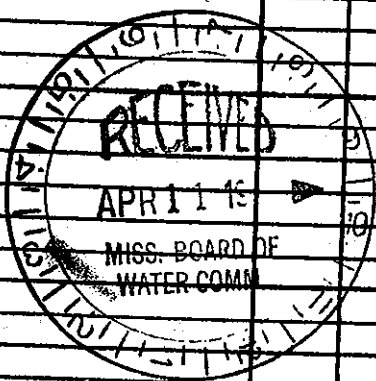

DRILLERS REMARKS: Well is very weak, water level pulls down to 110 ft.