


WATER WELL DRILLERS LOG

Date: 10-16-64, 1964, Driller: M^r Donald H. H. Tal, Clarke County (Name)

(1) Owner of Land:	Description & Color of Materials Sand, Clay, Red Clay, Shell, etc.	Thick- ness Feet	Depth Feet
Raymond Stallings (Name) Rt 2 Vossburg (Address)	CLAY	0	18
(2) Location: 1/4, 1/4, Sec. 9 T 8 R	SHALE	18	40
7 miles West of Shubuta (distance) (direction) (Nearest Town)	SAND	140	160
(3) Topography: X (Hilly) (Flat) (Level)			
(4) Purpose of Well: DOMESTIC (Domestic Irrigation Municipal, Industrial, Other)			
Information upon completion of well:			
(1) Diameter: 3 1/2" ST HOLE			
(2) Total Depth: 160' feet.			
(3) Water Level: 22' feet below top of ground.			
(4) Cased to: 156', Size: 2"			
(5) Screen: Size: 2", Length: 4' STEEL			
(6) Were any formations sealed against pollution? _____ yes, _____ no.			
If YES depth of formation _____			
Why _____			
Drillers Remarks: _____			

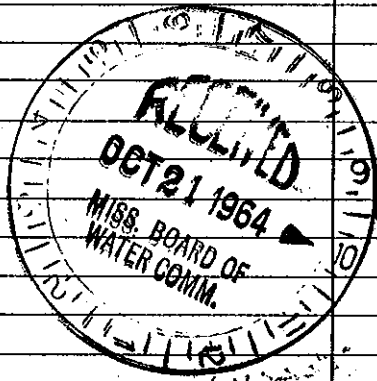

Well No.

(Use Back Side)