

Clarke
 9-6-66
 18

MISSISSIPPI BOARD OF WATER COMMISSIONERS

P

WATER WELL DRILLERS LOG

Date: Sept, 1966, Driller: People Drilling Co County Clarke
 (Name)


(1) Owner of Land: Jesse Allen
 (Name)
Rt 2 St Hubert, Miss
 (Address)
 (2) Location: NE 1/4, NW 1/4, Sec 20 T. 14 N. R. 15 E
8 miles NW, of St Hubert
 (distance) (direction) (Nearest Town)
 (3) Topography: Flat to Hilly
 (Hilly) (Flat) (Level)
 (4) Purpose of Well: Domestic
 (Domestic Irrigation
 Municipal, Industrial, Other)

Description & Color of Materials Sand, Clay, Red Clay, Shell, etc.	Thick- ness Feet	Depth Feet
<u>Yellow Sandy clay</u>		
<u>& clay</u>	<u>18</u>	<u>18</u>
<u>Blue clay</u>	<u>45</u>	<u>63</u>
<u>Blue limey clay & small</u>		
<u>limestone streak</u>	<u>31</u>	<u>94</u>
<u>Brown sandy shale</u>	<u>24</u>	<u>118</u>
<u>White sand & small</u>		
<u>Brown shale streak</u>	<u>35</u>	<u>153</u>

Information upon completion of well:

(1) Diameter 2 inches.
 (2) Total Depth 153 feet.
 (3) Water Level 35 feet below top of ground.
 (4) Cased to 147', Size 2"
 (5) Screen: Size 2", Length 6'
 (6) Were any formations sealed against pollution?
 _____ yes, no.

If YES depth of formation _____
 Why _____
 Drillers Remarks: _____

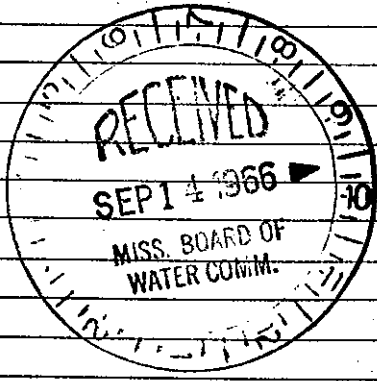

6

Well No.

(Use Back Side)