

Clarke
Q 24

10-29-62

MISSISSIPPI BOARD OF WATER COMMISSIONERS

WATER WELL DRILLERS LOG

Date: 10-29, 1962, Driller: McDONALD & HILL, Inc.

(Name)

CODED

		Description & Color of Materials Sand, Clay, Red Clay, Shell, etc.	Thick- ness Feet	Depth Feet
(1) Owner of Land: <u>Annie B. Carter</u> (Name) <u>Shubata, Miss.</u> (Address)		Clay	0	8
(2) Location: $\frac{1}{4}$, $\frac{1}{4}$, Sec. <u>8 10 N 8 W</u> <u>6</u> miles <u>W</u> , of <u>Shubata</u> (distance) (direction) (Nearest Town)		Chalk	8	32
(3) Topography: _____ (Hilly) (Flat) (Level)		soft shale	32	125
(4) Purpose of Well: <u>Domestic</u> (Domestic Irrigation Municipal, Industrial, Other)		limy shale	125	136
		sandy	136	140
		med. shale	140	155
			155	186
		limy shale, sand	186	202
		soft brown shale	202	235
		fine soft sand	235	271
		soft shale	271	290
		med. shale	290	300

Information upon completion of well:


- (1) Diameter 3 inches.
- (2) Total Depth 300 feet.
- (3) Water Level 50 feet below top of ground.
- (4) Cased to 105, Size 3
- (5) Screen: Size _____, Length _____
- (6) Were any formations sealed against pollution?
_____ yes, _____ no.

If YES depth of formation _____

Why _____

Drillers Remarks: _____

CODED

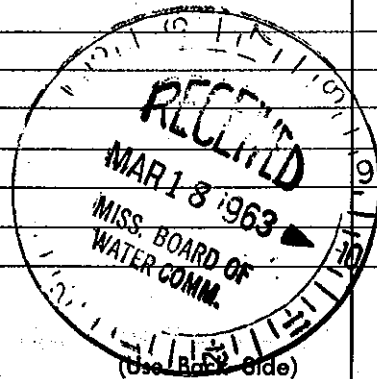

Well No.

Mail this copy to Board of Water Commissioners 429 Miss. St. Jackson, Miss.