

MISSISSIPPI DEPARTMENT OF NATURAL RESOURCES

Bureau of Land and Water Resources

Southport Mall

P.O. Box 10631

Jackson, Mississippi 39209

WATER WELL DRILLERS LOG

Clarke
~~R 9014~~
 Q83

6-16-82 date well completed Miss. Abstract firm name Clarke county well located

LANDOWNER:	description of formations encountered	from	to
<u>Clarke</u>			
<u>Shaw's</u> (mailing address)	<u>crack sand</u>	<u>10</u>	<u>30</u>
WELL LOCATION:			
sec: <u>4</u> T <u>1</u> N R <u>7</u> E <u>15E</u>			
<u>2</u> miles <u>N</u> of <u>Shubuta</u>			
(distance) (direction) (nearest town)			
WELL PURPOSE: <u>Home</u> (home, irrigation, municipal, industrial)			
WELL COMPLETION DATA:			
(1) diameter (inches) <u>9"</u>			
(2) total depth (feet) <u>30'</u>			
(3) static water level (feet) <u>1'</u> below above top of ground.			
(4) casing <u>2 1/2"</u> (material) <u>25'</u> (depth)			
<u>2 1/2"</u> (size) if telescope see back.			
(5) screen <u>2 1/2"</u> (length) <u>25'</u> (depth to top)			
<u>2 1/2"</u> (size) (material)			
(6) pump <u>10</u> (HP) <u>100</u> (yield gpm)			
<u>1</u> (type power)			
(7) electric log <u> </u> (yes or no)			
<u> </u> (organization running log)			
(8) how well bottom plugged <u> </u>			
DRILLERS REMARKS:			


DEPT. OF NATURAL RESOURCES
 BUREAU OF LAND & WATER RESOURCES

JUN 21 1982

RECEIVED

If well telescopes please sketch and show depths.

GROUND LEVEL

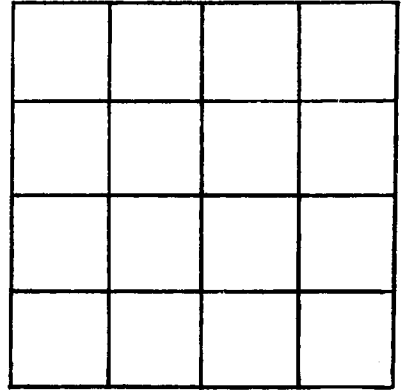

SECTION _____

Please indicate well location X.

ADDITIONAL INFORMATION

If more than one screen,
show locations of each on sketch.