

CLARKE MISSISSIPPI BOARD OF WATER COMMISSIONERS

R4
5-62

Sealed
WATER WELL DRILLERS LOG

Date: May, 1962, Driller: Peiper & Rutledge County Clarke
(Name)

	Description & Color of Materials Sand, Clay, Red Clay, Shell, etc.	Thick- ness Feet	Depth Feet
(1) Owner of Land: <u>C. E. Coaley</u> (Name)	<u>Top Soil & Clay -</u>	<u>10</u>	<u>10</u>
<u>Hubert</u> <u>Miss</u> (Address)	<u>Shale-Lime Shales</u>	<u>220</u>	<u>230</u>
(2) Location: <u>1/4</u> , <u>1/4</u> , Sec. <u>3</u> T <u>10</u> R <u>7W</u>	<u>SAND (Thin at top)</u>	<u>43</u>	<u>273</u>
_____ miles _____ of _____ (distance) (direction) (Nearest Town)			
(3) Topography: <u>Hilly</u> (Hilly) (Flat) (Level)			
(4) Purpose of Well: <u>Ranch</u> (Domestic Irrigation Municipal, Industrial, Other)			


Information upon completion of well:

- (1) Diameter 4 inches.
- (2) Total Depth 273 feet.
- (3) Water Level 70 feet below top of ground.
- (4) Cased to 189, Size 4"
- (5) Screen: Size 2", Length 12'
- (6) Were any formations sealed against pollution?
_____ yes, _____ no.

If YES depth of formation _____

Why _____

Drillers Remarks: _____

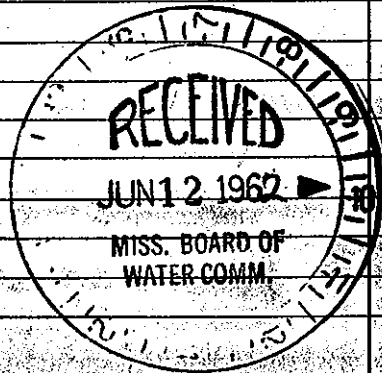

(Use Back Side)

Well No

Mail this copy to Board of Water Commissioners 429 Miss. St. Jackson, Miss.