

Clarke  
5 R 5  
7-66

MISSISSIPPI BOARD OF WATER COMMISSIONERS

9

WATER WELL DRILLERS LOG

Date: July, 1966, Driller: Peeples Drilling Co County Clarke  
(Name)

(1) Owner of Land: <u>Marie Parker</u> (Name)	Description & Color of Materials Sand, Clay, Red Clay, Shell, etc.	Thick- ness Feet	Depth Feet
<u>Rt. 2 Shubuta</u> (Address)	<u>Yellow sandy clay</u>	<u>18</u>	<u>18</u>
(2) Location: <u>NE 1/4, NE 1/4, Sec. 8 T. 16 N. R. 5 E.</u>	<u>lime &amp; limestone</u>	<u>27</u>	<u>45</u>
<u>8 miles NE</u> of <u>Shubuta</u> (distance) (direction) (Nearest Town)	<u>Brown shale sand streaks</u>	<u>15</u>	<u>60</u>
(3) Topography: <u>Flat to Hilly</u> (Hilly) (Flat) (Level)	<u>White sand + Brown shale streaks</u>	<u>30</u>	<u>90</u>
(4) Purpose of Well: <u>Home</u> (Domestic Irrigation Municipal, Industrial, Other)			

4

Information upon completion of well:

(1) Diameter 2 inches.

(2) Total Depth 90 feet.

(3) Water Level 6' feet below top of ground.

(4) Cased to 84', Size 2"


(5) Screen: Size 2", Length 6'

(6) Were any formations sealed against pollution?  
 yes,  no.

If YES depth of formation \_\_\_\_\_

Why \_\_\_\_\_

Drillers Remarks: \_\_\_\_\_

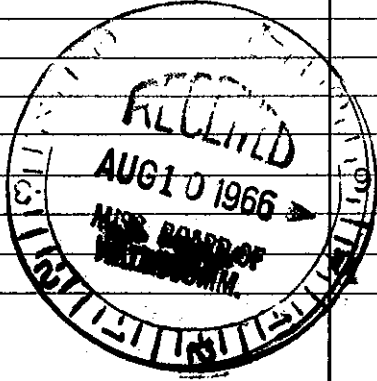

Well No.

(Use Back Side)

Mail this copy to Board of Water Commissioners 429 Miss. St. Jackson, Miss.