

CR 6
4-65

WATER WELL DRILLERS LOG

Date: April, 1965, Driller: Peoples Drilling Co County Clarke
(Name)

(1) Owner of Land:	Description & Color of Materials Sand, Clay, Red Clay, Shell, etc.	Thick- ness Feet	Depth Feet
(Name) Edward Carter, Jr	yellow sandy clay	8	8
(Address) Rt 2 Box 9 Shubuta	Blue sand	10	18
(2) Location: 1/4, 1/4, Sec. 25 T 14 R 16E	white limet limestone	24	42
6 miles NE of Shubuta	green limey shale	42	84
(distance) (direction) (Nearest Town)	white limet limestone	21	105
(3) Topography: Hilly	Brown shale sand	55	160
(Hilly) (Flat) (Level)	white sand shale	20	180
(4) Purpose of Well: Home			
(Domestic Irrigation Municipal, Industrial, Other)			

Information upon completion of well:

(1) Diameter ~~2~~ inches.

(2) Total Depth 180 feet.

(3) Water Level 65 feet below top of ground.

(4) Cased to 174', Size 2"


(5) Screen: Size 2", Length 6'

(6) Were any formations sealed against pollution?
_____ yes, _____ no.

If YES depth of formation _____

Why _____

Drillers Remarks: _____

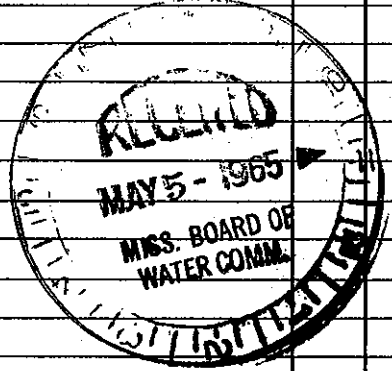

Well No.

(Use Back Side)