


CLARKE MISSISSIPPI BOARD OF WATER COMMISSIONERS

5 R7

5-22-63 WATER WELL DRILLERS LOG

Date: May 22, 1963, Driller: Porter Drilling & Ice County Clark

(1) Owner of Land:	Description & Color of Materials Sand, Clay, Red Clay, Shell, etc.	Thick- ness Feet	Depth Feet
Ralph Mc Lendon (Name)	sand	5	5
Shubuta Miss (Address)	clay	9	14
(2) Location: 1/4, 1/4, Sec. 16 T ^{10N} R ^{7W}	soft rock	2	16
1 miles SE of Shubuta (distance) (direction) (Nearest Town)	chals	5	21
(3) Topography: flat (Hill) (Flat) (Level)	blue chals & stratus of rocks	29	50
(4) Purpose of Well: water cattle (Domestic Irrigation Municipal, Industrial, Other)	blue chals	55	105
Information upon completion of well:	rock	2	107
(1) Diameter 2" inches.	chals	8	115
(2) Total Depth 372' feet.	shale, sand & chals	19	134
(3) Water Level flowing feet below top of ground.	sand	11	145
(4) Cased to 278', Size 2"	chals	3	148
(5) Screen: Size none, Length	sand mostly clean with some lignite	51	199
(6) Were any formations sealed against pollution?	very small flow obtained		
X yes, no .	chals & little sand	21	220
If YES depth of formation 16' 7" cas.	blue chals	38	257
Why cut off casing top sand	thin rock		257
Drillers Remarks:	blue chals & some sand	20	277
	stratus of soft rocks & blue chals	43	320
	red mud hole at 278' on rock		
	stiff chals	28	348
	clean med. sand	12	360
	chals & sand	6	366
	sand with lignite	6	372
	stopped while still in sand 1911		

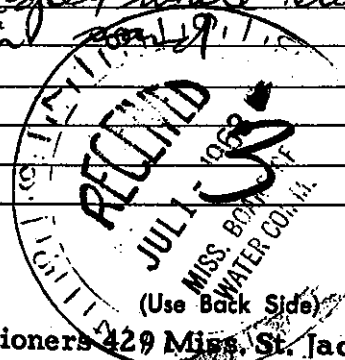

Well No.

Mail this copy to Board of Water Commissioners 429 Miss. St. Jackson, Miss.