

CLARKS

MISSISSIPPI BOARD OF WATER COMMISSIONERS

S R 8

6-23-62

WATER WELL DRILLERS LOG

P


Date: June 23, 1962, Driller: Porter Drilling & Supply Co. Clark  
(Name)

	Description & Color of Materials Sand, Clay, Red Clay, Shell, etc.	Thick- ness Feet	Depth Feet
(1) Owner of Land: <u>A. L. Toney</u> (Name)	<u>crayfish clay</u>	<u>12</u>	<u>12</u>
<u>Shubuta Miss</u> (Address)	<u>sand</u>	<u>8</u>	<u>20</u>
(2) Location: <u>1/4</u> , <u>1/4</u> , Sec. <u>6</u> <sup>10N 7W</sup> T. <u>R</u>	<u>blue chalk</u>	<u>42</u>	<u>62</u>
<u>2</u> miles <u>west</u> of <u>Shubuta</u> (distance) (direction) (Nearest Town)	<u>fine sand &amp; tight shale</u>	<u>10</u>	<u>72</u>
(3) Topography: <u>flat</u> (Hilly) (Flat) (Level)	<u>streaks of lime rock</u>	<u>7</u>	<u>79</u>
(4) Purpose of Well: <u>domestic</u> (Domestic Irrigation Municipal, Industrial, Other)	<u>blue chalk</u>	<u>65</u>	<u>144</u>
	<u>lime rock</u>	<u>4</u>	<u>148</u>
	<u>blue chalk</u>	<u>14</u>	<u>162</u>
	<u>fine sand mixed chalk</u>	<u>10</u>	<u>172</u>
	<u>med " &amp; lignite</u>	<u>10</u>	<u>182</u>
	<u>med " &amp; chalk</u>	<u>28</u>	<u>200</u>
	<u>course sand &amp; lignite</u>	<u>9</u>	<u>209</u>
	<u>stagnant white shell in chalk</u>		

Information upon completion of well:

- (1) Diameter 2" inches.
- (2) Total Depth 209 feet.
- (3) Water Level 2' feet below top of ground.
- (4) Cased to 188, Size 2"
- (5) Screen: Size 1 1/4", Length 12'
- (6) Were any formations sealed against pollution?  
no

2

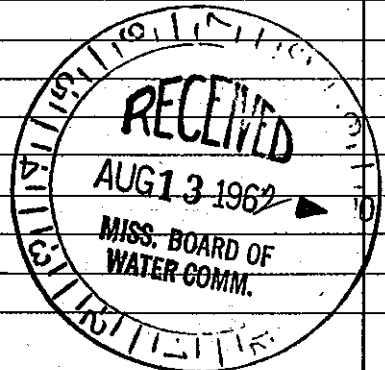

(Use Back Side)

Well No.

Mail this copy to Board of Water Commissioners 429 Miss. St. Jackson, Miss