

Clarke
R 14

MISSISSIPPI BOARD OF WATER COMMISSIONERS

WATER WELL DRILLERS LOG

11-9-62

Date: 11-9-1962, Driller: McDONALD & HILL, Inc.

CODED

(Name)

(1) Owner of Land: Percy Gray
(Name)
Shubuta, Miss.
(Address)

(2) Location: 1/4, 3 10N 7W
1/4, Sec. T R
3 miles SE of Shubuta
(distance) (direction) (Nearest Town)

(3) Topography: (Hilly) (Flat) (Level)

(4) Purpose of Well: Domestic
(Domestic Irrigation, Municipal, Industrial, Other)

Description & Color of Materials Sand, Clay, Red Clay, Shell, etc.	Thick- ness Feet	Depth Feet
Clay + shak	.0	45
soft Blue shale	45	100
limy shale	100	108
soft shale	108	138
med. limy	138	192
limy	192	195
soft sand	195	218
soft sand	218	235
# 8 sand	235	275
sandy shale	275	300

Information upon completion of well:

(1) Diameter 3 inches.

(2) Total Depth 300 feet.

(3) Water Level 105 feet below top of ground.

(4) Cased to 151, Size 3

(5) Screen: Size _____, Length _____


(6) Were any formations sealed against pollution?
_____ yes, no.

If YES depth of formation _____

Why _____

Drillers Remarks: _____

CODED

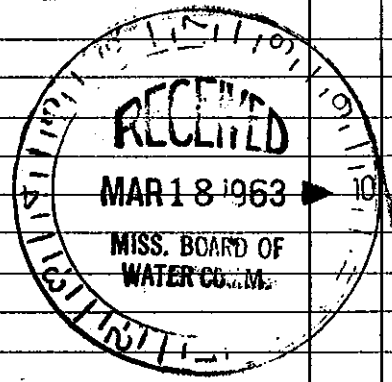

Well No.

(Use Back Side)