

Clarke
R 15

11-6-62

MISSISSIPPI BOARD OF WATER COMMISSIONERS

WATER WELL DRILLERS LOG

Date: 11-6, 1962, Driller: McDONALD & HILL, Inc.
P. O. Box 81

All Clarke Co. State Land
5/28/63
Coded

(1) Owner of Land: Peter Hollingsworth
Shubuta, Miss.
(Name)
(Address)
(2) Location: 4 10N 7W
3 miles SE of Shubuta
(distance) (direction) (Nearest Town)
(3) Topography: Domestic
(Hilly) (Flat) (Level)
(4) Purpose of Well: Domestic
(Domestic Irrigation
Municipal, Industrial, Other)

| Description & Color of Materials Sand, Clay, Red Clay, Shell, etc. | Thick- ness Feet | Depth Feet |
|---|------------------------|---------------|
| Clay | 0 | 30 |
| Soft blue shale | 30 | 85 |
| B. shale | 85 | 110 |
| Soft. fine | 110 | 140 |
| Hard shale | 140 | 198 |
| Sandy shale | 198 | 235 |
| # 8 sand | 235 | 270 |
| Sand | 270 | 275 |
| Shale - sandy | 275 | 300 |


Information upon completion of well:

(1) Diameter 3 inches.
(2) Total Depth 300 feet.
(3) Water Level 60 feet below top of ground.
(4) Cased to 147, Size 3
(5) Screens: Size _____, Length _____
(6) Were any formations sealed against pollution?
_____ yes, no.

If YES depth of formation _____

Why _____

Drillers Remarks: _____

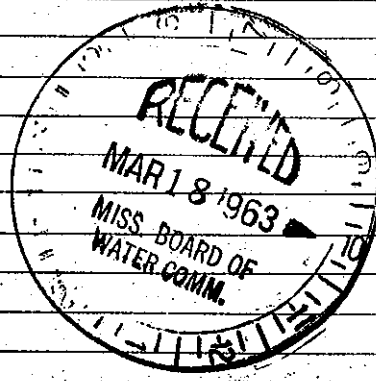

(Use Back Side)

Well No.

Retain this copy for your office files.