

R0041

11

|               |
|---------------|
| Clark         |
| <del>48</del> |
| 5-5-81        |

MISSISSIPPI  
 BOARD OF WATER COMMISSIONERS  
 416 North State Street  
 Jackson, Mississippi 39201

**USED**

WATER WELL DRILLERS LOG

5/5/81 date well completed      1981 Jerry Drilling Co. firm name      Clark county well located

| LANDOWNER:            | description of formations encountered | from | to  |
|-----------------------|---------------------------------------|------|-----|
| (mailing address)     |                                       |      |     |
| Mississippi Laminated | yellow clay + sand                    | 0    | 15  |
| Shubuta, Miss         | sandy                                 | 15   | 30  |
|                       | blue clay                             | 30   | 100 |
|                       | sandy                                 | 100  | 130 |
|                       | blue clay                             | 130  | 300 |
|                       | sandy streaks + R                     | 300  | 400 |
|                       | clay                                  | 400  | 440 |
|                       | clay                                  | 440  | 482 |

WELL LOCATION:  
 Sec. 8 T. 19 N. R. 13 E. S. 7 W. 13 E.  
 2 miles W of Shubuta (nearest town)

WELL PURPOSE:  
 (home, irrigation, municipal, industrial)

WELL COMPLETION DATA:

(1) diameter (inches) 4"

(2) total depth (feet) 482

(3) static water level (feet) 7 below top of ground

(4) casing Steel 254 (material) (depth)

2 (size) if telescope see back.

(5) screen 40 - 442 (length) (depth to top)

2" Stankers (size) (material)


(6) pump 2 (HP) 35 (yield gpm)

Sub (type power)

(7) electric log No (yes or no)

(organization running log)

(8) how well bottom plugged wash

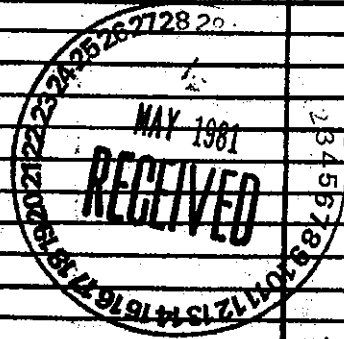

DRILLERS REMARKS: