

### STATE WELL REPORT

#### Part 1

#### Driller's Log

Mississippi Department of Environmental Quality  
 Office of Land and Water Resources  
 P.O. Box 2309  
 Jackson, MS 39225-2309  
 (601)961-5210  
 (601)360-0535 (fax)

#### For Office Use Only:

Well #: R56  
 Aquifer: \_\_\_\_\_  
 E-Log #: \_\_\_\_\_

County: Clarke  
 Permit #: \_\_\_\_\_  
 Driller: McDonald & Hill  
 Date drilling completed: 8/23/13

*State Law requires that this report be prepared by the license holder responsible for the work and filed with the Department at the above address within 30 days of completion of drilling of the well or borehole.*

Well Owner Information (Landowner if borehole is not for a water well)	Well or Borehole Location
Owner Name: <u>ERIC WAMBLER</u>	Latitude: <u>31-57-40</u> Longitude: <u>88-41-25</u>
Mailing Address: <u>14749 Scenic Hwy 78</u>	Method of Lat/Long (check one): Conventional Survey _____ USGS quad _____, Hand-held GPS _____, Survey-grade GPS _____
<u>Fairhope</u> <u>AL</u> <u>36536</u>	<u>NE 1/4 NE 1/4, Sec 6 T 1 N R 16E</u>
City State Zip Code	Miles _____ of _____ (Distance) (Direction) (Nearest Town)
Telephone No. (____) _____	

**Well / Borehole Data**

Date drilling started: 8/19/13 Date drilling completed: 8/23/13 Hole depth: 90 Hole diameter: 2"

Location of the source of any surface water used for drilling: well

Method of dosing and volume of Chlorine used in drilling and development: 1 lb per 1,000 gallons

Logs run (circle all applicable): No log run  Electric  Gamma Ray  Density  Sonic  Neutron  Other: \_\_\_\_\_

Name of organization running log(s): \_\_\_\_\_

Purpose of borehole (circle one):  Water Well  Geotechnical/Geological Investigation  Ground Source Heat Pump  
 Seismic Survey  Other (describe) \_\_\_\_\_

*If drilling is not related to water well construction, skip the remainder of this block*

Purpose of Well (circle all applicable):  Home  Industrial  Public Supply  Irrigation  Fish Culture

Other (describe): \_\_\_\_\_

If a flowing well, method of flow regulation: Valve \_\_\_\_\_ Other (describe) \_\_\_\_\_

Static Water Level: 25 feet [above or  below] land surface Date measured: 8/23/13  
(circle one)

Method of measurement (circle one):  Steel tape  Electric tape  Air line Other (describe): \_\_\_\_\_

Well depth: 90 Well grouted to a depth of: 10 feet Type of grout (circle one): Neat Cement  Bentonite  Mix

Casing length: 60 feet Casing diameter: 4 inches Type of casing: PVC

Screen length: 30 feet Screen diameter: 4 inches Type of screen: PVC

Screen slot size: .006 inches Setting depth: From 20 feet to -50 feet

Type of completion (circle all applicable): Gravel packed  Underreamed  Open hole  Natural Development

Other (describe): \_\_\_\_\_

Top of lap pipe or reduction in casing: \_\_\_\_\_ feet

*If telescoped or more than one screen, describe on next page*

RECEIVED



### STATE WELL REPORT

#### Part 2

**Pump Installer's Completion Report**  
 Mississippi Department of Environmental Quality  
 Office of Land and Water Resources  
 P.O. Box 2309  
 Jackson, MS 39225-2309  
 (601)961-5210  
 (601) 360-0535 (fax)

County: Clarks  
 Permit #: \_\_\_\_\_  
 Driller: McDonald & Hill  
 Date completed: 9/26/13  
*Copy information from block on Part 1*

**For Office Use Only:**  
 Well #: R56  
 Aquifer: \_\_\_\_\_

*This part of the report must be completed by a licensed water well contractor or a licensed pump installer. A copy of Part 1 of the report must be attached and both parts filed with the Department at the above address within 30 days of well completion.*

Well Owner Information	Well Location
Owner Name: <u>ERIC NAMBLE</u>	Latitude: _____ Longitude: _____
Mailing Address: <u>14749 Scenic Hwy 98</u>	Method of Lat/Long (check one): Conventional Survey _____
<u>Fairhope</u> <u>AL</u> <u>36536</u>	USGS quad _____, Hand-held GPS _____, Survey-grade GPS _____
City State Zip Code	_____ 1/4 _____ 1/4, Sec <u>10</u> T. <u>11N</u> R. <u>10E</u>
Telephone No. ( ) _____	_____ Miles of _____ (Distance) (Direction) (Nearest Town)

**Pump Type (circle one)**  
 Submersible  Turbine  Air Lift  Centrifugal  Flowing Well  Jet  Piston  Rotary  Other (describe): \_\_\_\_\_  
 Date Pump Installed: 9/20/13 Rated Pump Capacity: 7 Gallons Per Minute  
 Is This Pump (circle one):  New  Repaired  Replacement

**Power Type (circle one)**  
 Electric  Diesel  Gasoline  Natural Gas  Tractor PTO  Windmill  Other (describe): \_\_\_\_\_  
 Horse Power Rating of Motor: 1/2 Setting Depth: 20 feet Number of Stages: \_\_\_\_\_

**Pump Test Data for Non Flowing Well**  
 Date Well Tested: 9/26/13 Duration of Pump Test (minimum 4 hours): \_\_\_\_\_ hours  
 Static Water Level (A): 25 Feet Below Land Surface Pumping Water Level (B): 55 Feet Below Land Surface  
 Drawdown ((B) - (A)): 30 Feet Below Land Surface Test Pumping Rate: 5 Gallons Per Minute  
 Method of measurement (circle one):  Steel tape  Electric tape  Air line  Other (describe): \_\_\_\_\_

**Pump Test Data for Flowing Well**  
 Measured shut in head: \_\_\_\_\_ feet.  
 Well yielded \_\_\_\_\_ GPM with a drawdown of \_\_\_\_\_ feet after \_\_\_\_\_ hours of pumping


**Meter Installation**  
 Meter Manufacturer: \_\_\_\_\_ Meter Serial Number: \_\_\_\_\_  
 Meter Model Number/Name: \_\_\_\_\_ Type of Meter: \_\_\_\_\_  
 Totalizer Register Unit and Multiplier Factor (AF x .001, gal x 1000, etc): \_\_\_\_\_  
 Installation Date: \_\_\_\_\_ Meter installed by: \_\_\_\_\_  
 Is This Meter (circle one):  New  Repaired  Replacement  
*Important: By submitting the above information you are certifying that this meter was installed to manufacturer standards. For agricultural wells, a list of approved meters is on the MDEQ website.*

I HEREBY CERTIFY that the above statements are true to the best of my knowledge.  
McDonald & Hill #0-0 9/4/13 Harold Hill  
 Print Name of Pump Installer and License No. (if applicable) / Date Signature of Pump Installer

RECEIVED  
 BY: OLWR

Google


To see all the details that are visible on the screen, use the "Print" link next to the map.

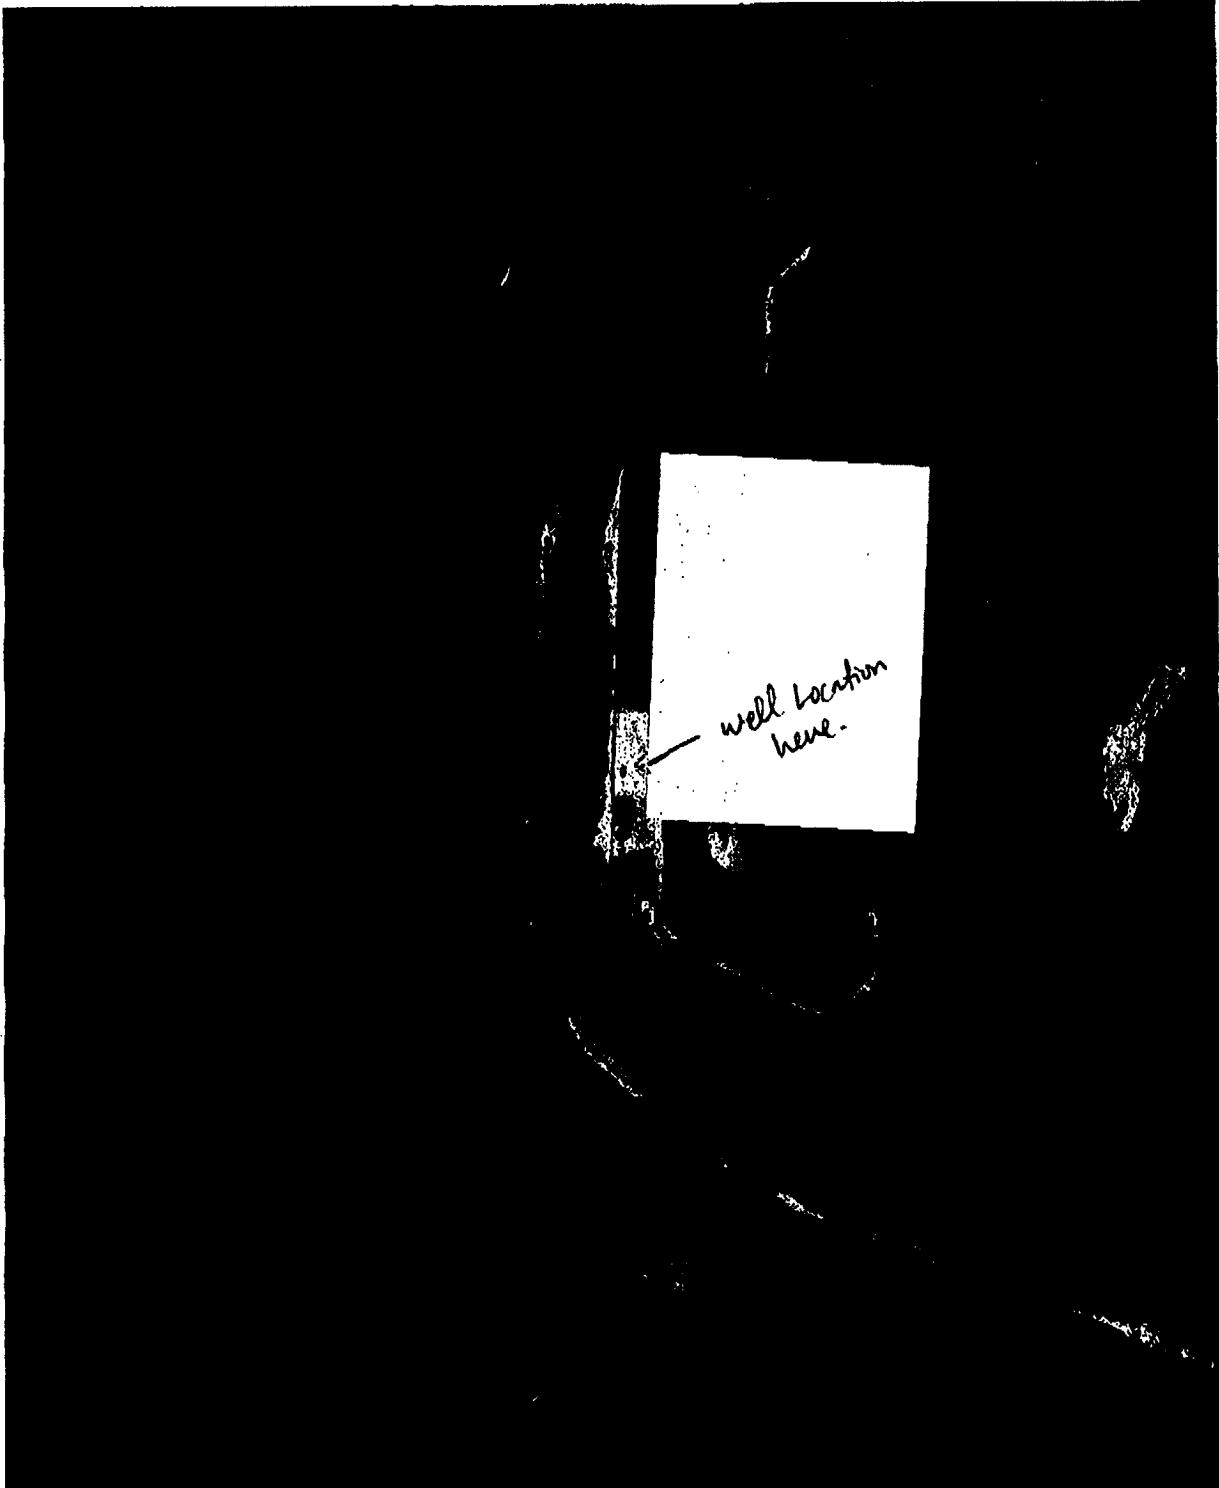

R56



Address **County Road 695**  
Shubuta, MS 39360

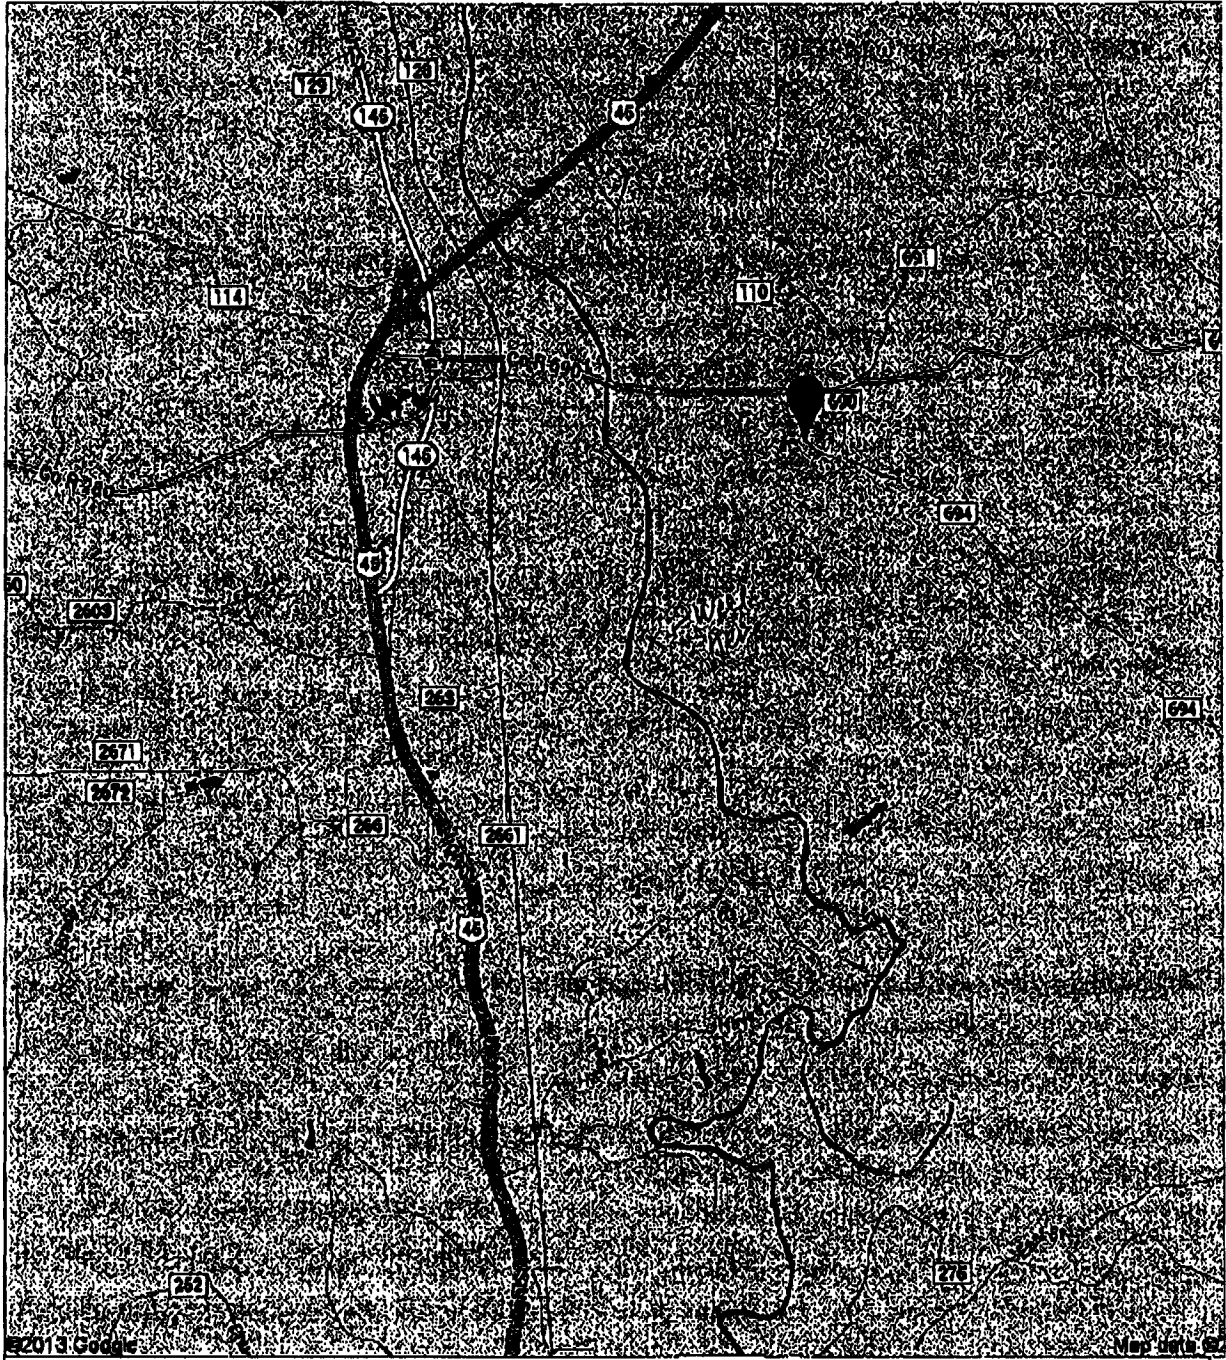

RECEIVED

BY: [Signature]