

MISSISSIPPI DEPARTMENT OF NATURAL RESOURCES

Bureau of Land and Water Resources

Southport Mall

P.O. Box 10631

Jackson, Mississippi 39209

WATER WELL DRILLERS LOG

CLARKE  
R 2011  
8-5-81

8-5-81

McDonald's Hill Clarke

date well completed

firm name

county well located

LANDOWNER:  
M. M. McEoy  
Shubuta  
(mailing address)


WELL LOCATION:  
sec. 25 T. 1 N. R. 7 E.  
2 miles N of Shubuta  
(distance) (direction) (nearest town)

WELL PURPOSE: home  
(home, irrigation, municipal, industrial)

WELL COMPLETION DATA:

- (1) diameter (inches) 4"
- (2) total depth (feet) 620'
- (3) static water level (feet) over flow  
top of ground.
- (4) casing PVC, 80'  
(material) (depth)  
4" if telescope see back.  
(size)
- (5) screen  
(length) (depth to top)  
(size) (material)
- (6) pump  
(HP) (yield gpm)  
(type power)
- (7) electric log  
(yes or no)  
(organization running log)
- (8) how well bottom plugged open

description of formations encountered	from	to
clay	0	10
sand & shale	10	60
shale & lignite	60	100
sandy shale & rock	100	170
shale	170	185
fine sand shale	185	215
1st lignite		
sandy shale	215	230
course to fine sand	230	250
fine sand & sandy shale	250	300
shale		
fine sand	300	310
sandy shale & coarse sand	310	370
shale	370	390
sandy shale & shell	390	400
rock	400	410
rock & sandy shale	410	420
green sand	420	450
shale & rock at bank	450	525
fine sand	525	530
rock & shale	530	580
course green sand & shale	580	620

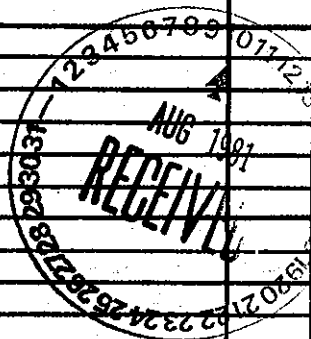

DRILLERS REMARKS: