

Clarke
3 54
1-67

MISSISSIPPI
BOARD OF WATER COMMISSIONERS
416 North State Street
Jackson, Mississippi 39201

WATER WELL DRILLERS LOG

1-9-67 19 McDonald & Well, Inc. CLARK
date well completed firm name county well located

LANDOWNER: ROSHEA WILLIAMS

description of formations encountered

from to

Rt 2

CLAY

0 20

Vossburg

SHALE

20 70

(mailing address)

FINE SAND

70 105

SAND 10-12 SLOT

105 125

WELL LOCATION:


sec 5 T 1 N R 17 E
S W
8 miles S.EAST of DESOTO
(distance) (direction) (nearest town)

WELL PURPOSE: HOME
(home, irrigation, municipal, industrial)

WELL COMPLETION DATA:

- (1) diameter (inches) 3 7/8 TEST HOLE
- (2) total depth (feet) 125'
- (3) static water level (feet) 25' below top of ground.
- (4) casing 2" GALV 120'
(material) (depth)
2
(size) If telescope see back.
- (5) screen 5' 120'
(length) (depth to top)
2" GALV PIPE
(size) (material)
- (6) pump 1/2 HP JET 6 PUMP ONLY
(HP) (yield gpm)
230 VOLTS
(type power)
- (7) electric log NO
(yes or no)

5

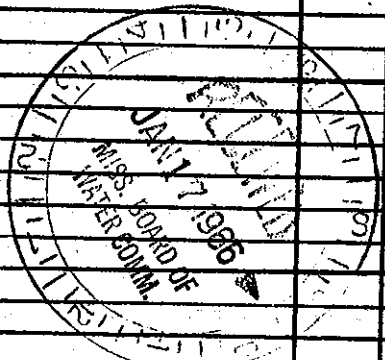

(organization running log)

(8) how well bottom plugged BACK WASH VALVE

DRILLERS REMARKS: