

U

MISSISSIPPI
 BOARD OF WATER COMMISSIONERS P
 416 North State Street
 Jackson, Mississippi 39201

WATER WELL DRILLERS LOG

Clarke
 255
 1-67


1-19-67 19 date well completed
 McDonald & Hill Inc firm name
 CLARK county well located

LANDOWNER: DAVIS RILEY
CARMICHAEL MISS
 (mailing address)
 WELL LOCATION:
 sec. 7 T 14 N R 17 E
 S W
 In Carmichael miles CARMICHAEL MISS
 (distance) (direction) (nearest town)

description of formations encountered	from	to
CLAY ST SAND	0	28
SHALE	28	40
SHALE ST SAND	40	110
SHALE	110	230
SAND	230	250
SHALE	250	260
SAND	260	300

WELL PURPOSE: HOME
 (home, irrigation, municipal, industrial)

WELL COMPLETION DATA:
 (1) diameter (inches) 4" WELL
 (2) total depth (feet) 300'
 (3) static water level (feet) _____ below above top of ground.
 (4) casing BLACK PIPE 210'
 (material) (depth)
4" if telescope see back.
 (size)
 (5) screen 10' 280'
 (length) (depth to top)
2" Brass
 (size) (material)
 (6) pump 3/4 HP sub 10 GPM
 (HP) (yield gpm)
230
 (type power)
 (7) electric log No
 (yes or no)
 (organization running log)
 (8) how well bottom plugged BACK WASH VALVE

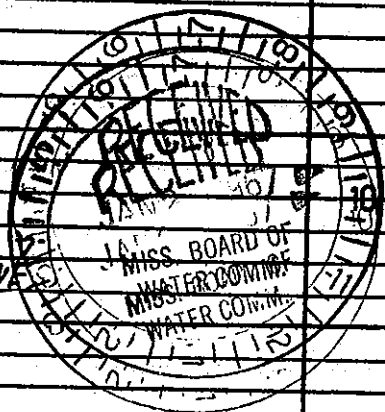

DRILLERS REMARKS: