

Clarke

3 56

9-67

MISSISSIPPI
 BOARD OF WATER COMMISSIONERS
 416 North State Street
 Jackson, Mississippi 39201

WATER WELL DRILLERS LOG

9.23.67 date well completed
 McDONALD + HILL firm name
 CLARK county well located

LANDOWNER: CLINTON NAPP
 R# 4 QUITMAN
 (mailing address)


description of formations encountered	from	to
CLAY	0	20
SANDY CLAY	20	35
SHALE	35	60
SANDY ST SHALE	60	115
SHALE	115	170
SANDY LIME ST SHALE	170	260
SAND	260	290

WELL LOCATION:
 sec. 5 T. 1 N R. 7 E
 S W
 3 miles SOUTH of CRANDALL
 (distance) (direction) (nearest town)

WELL PURPOSE: HOME
 (home, irrigation, municipal, industrial)

WELL COMPLETION DATA:

- (1) diameter (inches) 4" WELL
- (2) total depth (feet) 290'
- (3) static water level (feet) 75' below top of ground.
- (4) casing BLACK 160' (material) (depth)
 4" (size) if telescope see back.
- (5) screen 10' 280' (length) (depth to top)
 2" BRASS (size) (material)
- (6) pump 1/2 506 10 (HP) (yield gpm)
 220 (type power)
- (7) electric log NO (yes or no)
 (organization running log)
- (8) how well bottom plugged VALUE

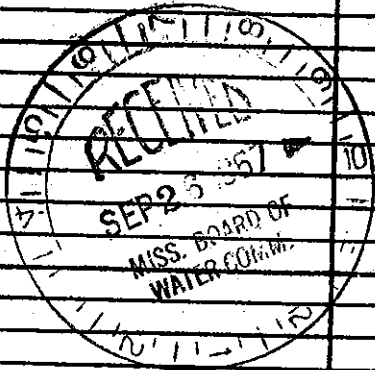

DRILLERS REMARKS: