

Clarke  
3 57  
9-67

MISSISSIPPI  
BOARD OF WATER COMMISSIONERS  
416 North State Street  
Jackson, Mississippi 39201

WATER WELL DRILLERS LOG

9.28.67 19 McDonald + Hill CLARK  
date well completed firm name county well located

LANDOWNER: JULIA MILLER  
CARMICHAEL MISS  
(mailing address)


WELL LOCATION:  
sec. 18 T. 1 N R. 17 E  
S W  
3 miles S EAST of Carmichael  
(distance) (direction) (nearest town)

WELL PURPOSE: HOME  
(home, irrigation, municipal, industrial)

WELL COMPLETION DATA:

- (1) diameter (inches) 4" WELL
- (2) total depth (feet) 350
- (3) static water level (feet) 144 below above top of ground.
- (4) casing 8" black, 176' (material) (depth)  
4" If telescope see back. (size)
- (5) screen 10' 340' (length) (depth to top)  
2" BRASS (size) (material)
- (6) pump 3/4 506 10 (HP) (yield gpm)  
220 (type power)
- (7) electric log NO (yes or no)  
NO (organization running log)
- (8) how well bottom plugged VALVE

description of formations encountered	from to	
Clay St sand	0	35
Shale	35	95
Soft sandy shale	95	145
Shale	145	210
Soft sandy fine	210	240
Shale 1st fine rock	240	295
Brown shale	295	325
Sand	325	350

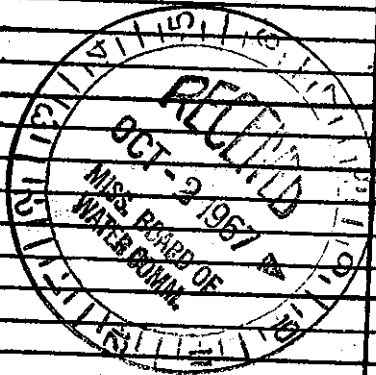

DRILLERS REMARKS: