

CLARKE  
58  
3-7-66

MISSISSIPPI BOARD OF WATER COMMISSIONERS

D

WATER WELL DRILLERS LOG

Date: July, 1966, Driller: Peoples Drilling Co County Clarke  
(Name)

(1) Owner of Land:	Description & Color of Materials Sand, Clay, Red Clay, Shell, etc.	Thick- ness Feet	Depth Feet
<u>Lessie Kirksey</u> (Name) <u>RFD Quitman, Miss</u> (Address)	<u>Yellow sandy clay</u>	<u>18</u>	<u>18</u>
(2) Location: <u>NW 1/4, NE 1/4, Sec. 10, T. 17 N., R. 17 E.</u> <u>4</u> miles <u>S</u> of <u>Cannibal</u> (distance) (direction) (Nearest Town)	<u>Gray shaly sand</u>	<u>42</u>	<u>60</u>
(3) Topography: <u>Hilly</u> (Hilly) (Flat) (Level)	<u>lim + limestone</u>	<u>82</u>	<u>142</u>
(4) Purpose of Well: <u>Home</u> (Domestic Irrigation Municipal, Industrial, Other)	<u>gray sandy shaly</u>	<u>20</u>	<u>162</u>
	<u>sand shaly</u>	<u>12</u>	<u>174</u>
	<u>white sand</u>		


Information upon completion of well:

- (1) Diameter 2 inches.
- (2) Total Depth 174' feet.
- (3) Water Level 118 feet below top of ground.
- (4) Cased to 108', Size 2"
- (5) Screen: Size 2", Length 6'
- (6) Were any formations sealed against pollution?  
no

If YES depth of formation \_\_\_\_\_

Why \_\_\_\_\_

Drillers Remarks: \_\_\_\_\_

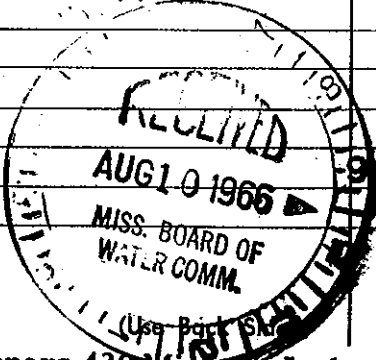

Well No. \_\_\_\_\_