

CLARKE

## MISSISSIPPI BOARD OF WATER COMMISSIONERS

6 S 9

1-65

## WATER WELL DRILLERS LOG

P

Date: Jan, 1965, Driller: Peoples Drilling Co. County: Clarke  
(Name)(1) Owner of Land: Benie Nichole  
(Name)  
Carmichael, Miss.  
(Address)(2) Location: 1/4, 1/4, Sec. 26 T14N R7E  
7 miles S, of Crandall  
(distance) (direction) (Nearest Town)(3) Topography: Hilly  
(Hilly) (Flat) (Level)(4) Purpose of Well: Home  
(Domestic Irrigation  
Municipal, Industrial, Other)Description & Color of Materials  
Sand, Clay, Red Clay, Shell, etc.Thick-  
ness  
FeetDepth  
Feet

|                                |     |     |
|--------------------------------|-----|-----|
| Yellow Sandy clay              | 21  | 21  |
| Blue marl                      | 52  | 73  |
| Gray Sandy shale + sand streak | 67  | 140 |
| Gray sand                      | 12  | 152 |
| Gray shale                     | 21  | 173 |
| lime + limestone               | 117 | 290 |
| Green limy shale               | 12  | 302 |
| Brown sandy shale              | 8   | 310 |
| Brown + white sand             | 50  | 360 |


## Information upon completion of well:

- (1) Diameter 2 inches.
- (2) Total Depth 360 feet.
- (3) Water Level 115 feet below top of ground.
- (4) Cased to 354, Size 2
- (5) Screen: Size 2, Length 6
- (6) Were any formations sealed against pollution?  
yes, no.

If YES depth of formation

Why

Drillers Remarks:

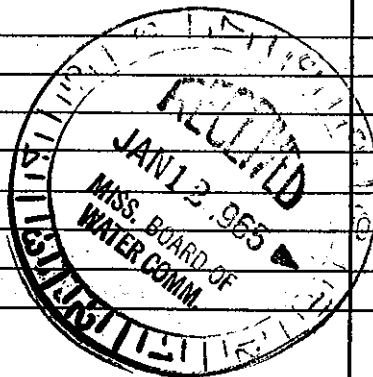

(Use Back Side)

Well No.

Mail this copy to Board of Water Commissioners 429 Miss. St. Jackson, Miss.