

CLARKE

WATER WELL DRILLERS LOG

P S

Date: May 5-63, 1963, Driller: Reaper Drilling Co County Clarke

(Name)

(1) Owner of Land: Earle Holliman
(Name)

(Address)

(2) Location: 1/4, 1/4, Sec. 1 T¹N R17E

1 miles SE of CRANDALL
(distance) (direction) (Nearest Town)

(3) Topography: Hilly
(Hilly) (Flat) (Level)

(4) Purpose of Well: Domestic
(Domestic Irrigation
Municipal, Industrial, Other)

Description & Color of Materials Sand, Clay, Red Clay, Shell, etc.	Thick- ness Feet	Depth Feet
Yellow Sand & Sandy Clay	35	35
Blue marl	7	42
Green limestone	11	53
White sand & Green limy shale	42	95
Brown shale	10	105
Brown sand & Brown sand	52	157
Brown sand	48	205
Gray shale	15	220
Green limy shale	11	231
Green limy shale & Hard limestone	24	255
Green limestone & Green sand streak	39	294
Green rock & Green shale streak	105	399
Gray shale & Sandy shale	48	447
White sand & Gray sand	25	472
Gray sandy shale & Sand streak	13	485

Information upon completion of well:

(1) Diameter 4 inches.

(2) Total Depth 485 feet.

(3) Water Level 75 feet below top of ground.

(4) Cased to 336', Size 4"


(5) Screen: Size 2", Length 12'

(6) Were any formations sealed against pollution?
_____ yes, _____ no.

If YES depth of formation _____

Why _____

Drillers Remarks: _____

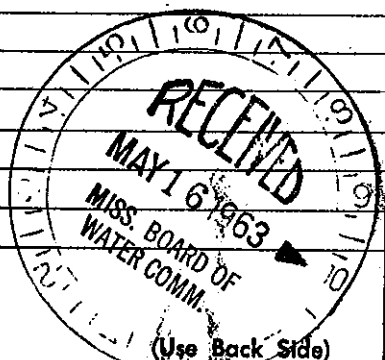

Well No.

Mail this copy to Board of Water Commissioners 429 Miss. St. Jackson, Miss