

MISSISSIPPI BOARD OF WATER COMMISSIONERS

Clarke
S-18

WATER WELL DRILLERS LOG

7-13-60

Date: 7.13, 1960, Driller: McDonald Hill Shubert
(Name)


CODED

(1) Owner of Land: <u>P O FAGAN</u> (Name)	Description & Color of Materials Sand, Clay, Red Clay, Shell, etc.	Thick- ness Feet	Depth Feet
<u>Rt 4 Quitman</u> (Address)	<u>Clay</u>	<u>0</u>	<u>10</u>
(2) Location: <u>3 N/7E</u> <u>J-R</u> (Center)	<u>Sand</u>	<u>10</u>	<u>17</u>
<u>14</u> miles <u>EAST</u> of <u>Quitman</u> (distance) (direction) (Nearest Town)	<u>Shale</u>	<u>17</u>	<u>45</u>
(3) Topography: <u>X</u> (Hilly) (Flat) (Level)	<u>Soft Shale</u>	<u>45</u>	<u>60</u>
(4) Purpose of Well: <u>DOMESTIC</u> (Domestic Irrigation Municipal, Industrial, Other)	<u>Thin Lt. Shale</u>	<u>60</u>	<u>77</u>
	<u>Soft Shale</u>	<u>77</u>	<u>90</u>
	<u>Thin Shale</u>	<u>90</u>	<u>110</u>
	<u>Brown Shale</u>	<u>110</u>	<u>130</u>
	<u>Sand</u>	<u>130</u>	<u>160</u>

Information upon completion of well:

- (1) Diameter 2" inches.
 - (2) Total Depth 160' feet.
 - (3) Water Level 35' feet below top of ground.
 - (4) Cased to 152', Size 2"
 - (5) Screen: Size 2", Length 5'
 - (6) Were any formations sealed against pollution?
no yes, no no.
- If YES depth of formation _____
- Why _____
- Drillers Remarks: _____

CODED

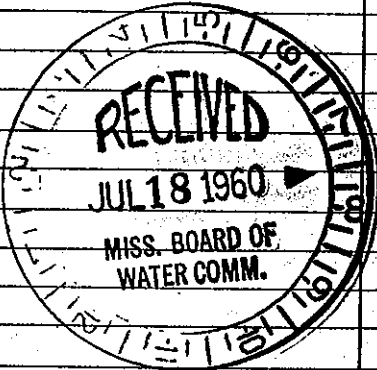

Well No.

(Use Back Side)

Mail this copy to Board of Water Commissioners 429 Miss. St. Jackson, Miss.