


TESS
US 2

CODED

Clarke
S23
9-28-68
9-28-68

MISSISSIPPI
BOARD OF WATER COMMISSIONERS
416 North State Street
Jackson, Mississippi 39201

WATER WELL DRILLERS LOG

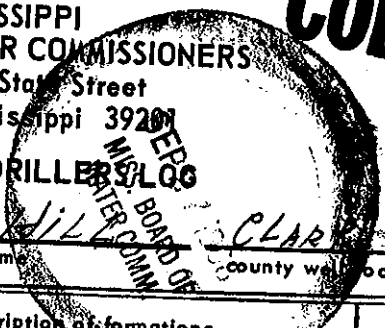

date well completed 9-28-68 firm name McDONALD + HILL county well located CLARKE

LANDOWNER: JACK CARMICHAEL

description of formations encountered

CARMICHAEL MISS
(mailing address)

description of formations encountered	from	to
Clay	0	16
Sandy Clay	16	50
Shale	50	120
Soft Sandy Limestone	120	190
Shale	190	220
Sand	220	260

WELL LOCATION:
sec. 7 T 1 N R 17 E
S W
(distance) miles (direction) of (nearest town)

WELL PURPOSE: HOME
(home, irrigation, municipal, industrial)

WELL COMPLETION DATA:

CODED

- (1) diameter (inches) 4" WELL
- (2) total depth (feet) 260'
- (3) static water level (feet) 120' below top of ground.
- (4) casing PVC 200'
(material) (depth)
4" (size) if telescope see back.
- (5) screen 10' 250'
(length) (depth to top)
2" PVC
(size) (material)
- (6) pump 1/2 10
(HP) (yield gpm)
220
(type power)
- (7) electric log NO
(yes or no)
NO
(organization running log)
- (8) how well bottom plugged VALVE

DRILLERS REMARKS: