

CLARKE

S 39

10-18-73

C. P. CLARK
WATER WELL DRILLING
MISSISSIPPI
BOARD OF WATER COMMISSIONERS
416 North State Street
Jackson, Mississippi 39201

CODED

WATER WELL DRILLERS LOG

10/18 1973
date well completed

C. P. Clark
firm name

Clarke
county well located

LANDOWNER: John Henry Long
Matherville, Miss

(mailing address)

WELL LOCATION:

sec. 31 T. 1 (N) R. 17 (E)
2 miles N of Matherville
(distance) (direction) (nearest town)


WELL PURPOSE: Home
(home, irrigation, municipal, industrial)

WELL COMPLETION DATA:

- (1) diameter (inches) 2
- (2) total depth (feet) 158
- (3) static water level (feet) 80 below top of ground.
- (4) casing Galv. Steel 1 1/2" (material) (depth)
- (5) screen 18" (length) 147" (depth to top)
1 1/4" (size) S.S. Strainer 80 (material)
- (6) pump 2 (HP) 6 (yield gpm)
220V (type power)
- (7) electric log NO (yes or no)
- (8) how well bottom plugged BWW

description of formations encountered	from	to
Clay	0	8
fine Sand	8	18
Clay + Rock Shales	18	100
Clay + Shells	100	105
Clay	105	122
Sandy Clay	122	130
Clay	130	147
Sand (fine)	147	165

CODED

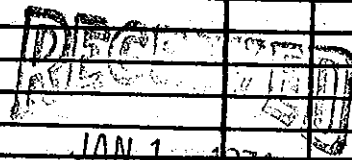

JAN 14 1974

MISS. BD. OF WATER COMM

DRILLERS REMARKS: Sit. 12A
fit @ 126 ft