

CLARKE

340

1-18-74

MISSISSIPPI BOARD OF WATER COMMISSIONERS
416 North State Street
Jackson, Mississippi 39201

CODED

WATER WELL DRILLERS LOG

1-18-74 date well completed
McDONALD + HILL firm name
CLARK county well located


LANDOWNER	description of formations encountered	from	to
ALVIN CAMPBELL	CLAY	0	14
RT #4	SHALE	14	98
Quitman, Miss	SAND & CLAY	98	146
(mailing address)	SHALE	146	270
	SAND	270	300

WELL LOCATION:
sec 2 T 1 N R 17 E
1 mile EAST of CAMPBELL
(distance) (direction) (nearest town)

WELL PURPOSE: HOME
(home, irrigation, municipal, industrial)

- WELL COMPLETION DATA:
- (1) diameter (inches) 2"
 - (2) total depth (feet) 300'
 - (3) static water level (feet) 78' below top of ground.
 - (4) casing GALV 290' (material) (depth)
2" (size) if telescope see back.
 - (5) screen 5' 290' (length) (depth to top)
2" PVC (size) (material)
 - (6) pump (HP) (yield gpm)
(type power)
 - (7) electric log (yes or no)
(organization running log)
 - (8) how well bottom plugged VALVE

LODGE

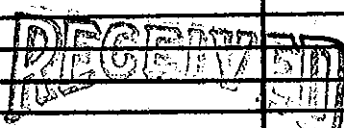

JAN 23 1974

MISS. BD. OF WATER COMM

DRILLERS REMARKS:
1-2" CYLINDER SET
175'
20' - 4" PVC