

CLARKE
S 43
6-6-74

MISSISSIPPI
 BOARD OF WATER COMMISSIONERS
 416 North State Street
 Jackson, Mississippi 39201 **CODED**

WATER WELL DRILLERS LOG

6-6 1974 McDonald & Hill Inc Clarke
 date well completed firm name county well located

LANDOWNER: Jurlee Robinson
pt # 2 Box 175
Waynesboro, Miss
 (mailing address)

WELL LOCATION:
 sec. 22 T 1 N R 17 E
5 miles east of Carmichael
 (distance) (direction) (nearest town)

WELL PURPOSE: None
 (home, irrigation, municipal, industrial)

WELL COMPLETION DATA:

(1) diameter (inches) 4"

(2) total depth (feet) 347'

(3) static water level (feet) 88' below above top of ground.

(4) casing 4" PVC 207'
 (material) (depth)

(size) if telescope see back.

(5) screen 12' 335'
 (length) (depth to top)

2" PVC
 (size) (material)

(6) pump _____
 (HP) (yield gpm)

(type power)


(7) electric log no
 (yes or no)

(organization running log)

(8) how well bottom plugged back
pressure valve

| description of formations encountered | from | to |
|---------------------------------------|------|-----|
| Clay | 0 | 20 |
| limy shale, st rock | 20 | 65 |
| shale | 65 | 110 |
| limy shale, st rock | 110 | 130 |
| sand, st brown shale | 130 | 200 |
| shale | 200 | 230 |
| limy shale, st rock | 230 | 295 |
| shale | 295 | 318 |
| Coarse sand | 318 | 347 |

CODED

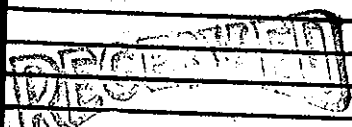

JUN 10 1974

DRILLERS REMARKS: None

MISS. BD. OF WATER COMM.