

State Well Report

Part 1

Mississippi Department of Environmental Quality
Office of Land and Water Resources
P.O. Box 10631
Jackson, MS 39289-0631
(601)961-5210
(601)354-6938 (fax)

For Office Use Only:

Aquifer: _____
Well #: 5-57
L. S. Elevation: _____
E-log #: _____

County: Clarke
Permit #: _____
Driller: McDonald & Hill
Date drilling completed: 6-22-05

State Law requires that this report be prepared by the driller in detail and filed with the Department within 30 days of completion of drilling of the well.

Well Owner Information	Well Location
Owner Name: <u>Hilton Davis</u>	Latitude: _____ Longitude: _____
Mailing Address: <u>1719 - CR 620</u>	Method of Lat/Long (circle one): Conventional Survey, _____
<u>Waynesboro MS 39367</u>	USGS quad, Hand-held GPS, Survey-grade GPS
City State Zip Code	_____ 1/4 _____ 1/4 Sec <u>26</u> Twn <u>1N</u> Rng <u>17E</u>
Telephone No. <u>601-687-1674</u>	Distance _____ Direction _____ Nearest Town _____
	<u>4</u> Miles <u>SE</u> of <u>Waynesboro</u>

Well Data

Purpose of Well (circle one) Home Industrial Public Supply Irrigation Fish Culture Other: Chickens

Date well drilling started: 6-21-05 Date well drilling completed: 6-22-05

If flowing, method of flow regulation: Valve _____ Other (describe) _____

Static Water Level: 75 feet above or below (circle one) land surface Date measured: 6-22-05

Method of Measurement (circle one) steel tape electric tape air line other: _____

Hole depth: 370 Well depth: 350 Well grouted to a depth of 10 feet

Type of grout (circle one): Cement Bentonite Mix _____

Casing length: 320 feet Casing diameter: 4 inches Type of casing: PVC

Screen length: 50 feet Screen diameter: 4 inches Type of screen: PVC

Screen slot size: #14 inches Setting depth: From 320 feet to 350 feet

Type of completion (circle all applicable): Gravel packed Underreamed Telescoped Open hole Natural Development

Other (describe): _____

Top of lap pipe or reduction in casing: _____ feet. If telescoped or more than one screen, describe on back of page

Logs run (circle all applicable): No log run Electric Gamma Ray Density Sonic Neutron Other: _____

Name of organization running log(s): _____

I certify that the well was drilled, constructed, and completed in accordance with all applicable requirements of the Mississippi Department of Environmental Quality and/or the Mississippi Department of Health regulations and state laws.

McDonald & Hill, Inc. # 0-8
Print Name of Water Well Contractor and License No.


Burdie
Signature of Water Well Contractor

RECEIVED
JUL 21 2005
BY: OLWR

If well telescopes please sketch below and show depths.

5-57

Ground Level

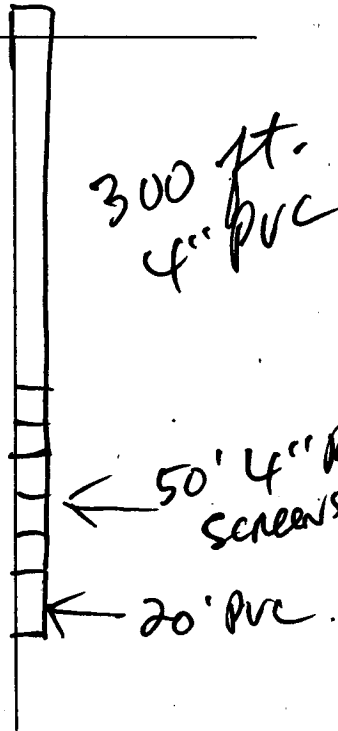


Description of Formations Encountered	From	To
CLAY, SANDY	0	20
shale Rock / st	20	60
SHALE	60	100
SHALE, SANDY SHALE, ROCK	100	300
SAND # 14	300	350
SHALE	350	370

If more than one screen, show location of each on sketch

Sketch the property layout and include the following: 1) the well location; 2) any permanent structures on the property that may aid in locating the well; 3) any roads, power lines, or other items that may aid in locating the property and the well; 4) indicate direction.

4 new Chicken Houses

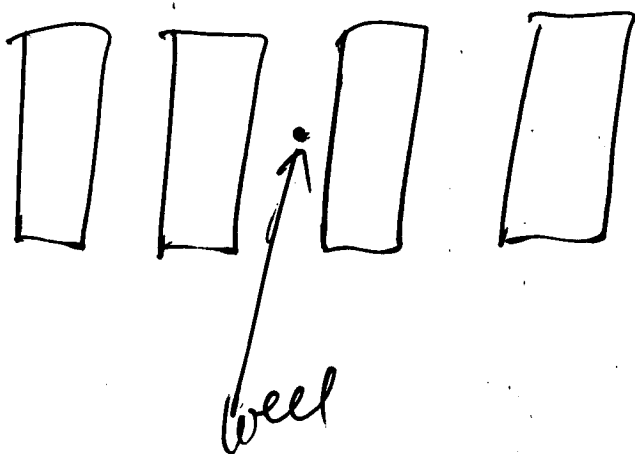

Landowner Name: Horton Davis

Bur Hill
Signature of Water Well Contractor

RECEIVED
JUL 21 2005
BY: OLWR

STATE WELL REPORT

Part 2

County: Clark
Permit #: _____
Driller: McDonald & Hill
Date completed: 6-22-05

Pump Installer's Completion Report
Mississippi Department of Environmental Quality
Office of Land and Water Resources
P.O. Box 10631
Jackson, MS 39289-0631
(601)961-5210
(601)354-6938 (fax)

For Office Use Only:
Aquifer: _____
Well #: 5-57
Elevation: _____

This report should be prepared by the pump installer in detail and filed with the Department within 30 days of the installation of pump.

Well Owner Information	Well Location
Owner Name: <u>Hilton Davis</u>	Latitude: _____ Longitude: _____
Mailing Address: <u>1719 - CR 620</u>	Method of Lat/Long (circle one): Conventional Survey,
<u>Waynesboro, MS - 39367</u>	USGS quad, Hand-held GPS, Survey-grade GPS
City State Zip Code	1/4 _____ 1/4 Sec <u>26</u> Twn <u>1N</u> Rng <u>R7E</u>
Telephone No: <u>(601) 687-1674</u>	Distance Direction Nearest Town
	<u>4</u> Miles <u>SE</u> of <u>Crane Hill</u>

Pump Type Circle one	Power Type Circle one
Air Lift Jet <u>Submersible</u>	Diesel Engine Gasoline Engine Natural Gas
Bucket Piston Turbine <u>Electric Motor</u>	Hand Tractor PTO
Centrifugal Rotary Flowing Well	Windmill Other (specify): _____
Other (specify): _____	Horse Power Rating of Motor: <u>5</u>
Date Pump Installed: <u>6-23-05</u>	Setting Depth: <u>180</u> feet
Rated Pump Capacity: <u>55</u> Gallons Per Minute	Number of Stages: <u>11</u>

Pump Test Data	Method of Measuring Water Level Circle one
Date Well Tested: <u>6-23-05</u>	Air Line Electric Measuring Line <u>Steel Tape</u>
Static Water Level (A): <u>75</u> Feet Below Land Surface	Other (specify): _____
Pumping Water Level (B): <u>125</u> Feet Below Land Surface	For flowing well, measured shut in head: _____ feet
Drawdown [(B) - (A)]: <u>50</u> Feet Below Land Surface	Well yielded <u>60</u> GPM with a drawdown of
Test Pumping Rate: <u>60</u> Gallons Per Minute	<u>50</u> feet after <u>2</u> hours of pumping
Duration of Pump Test (minimum 4 hours): <u>4</u> hours	

I HEREBY CERTIFY that the above statements are ~~true~~ to the best of my knowledge.

McDonald & Hill, Inc. 0-8 Bar Hill
Print Name of Pump Installer and License No. (if applicable) Signature of Pump Installer

RECEIVED
JUL 21 2005
BY: OLWR