

Log # 31 **CODED**

MISSISSIPPI  
BOARD OF WATER COMMISSIONERS  
416 North State Street  
Jackson, Mississippi 39201

WATER WELL DRILLERS LOG

Clay  
A 4  
9-68  
WSGS

date well completed Sept. 1968 firm name R. E. Ratliff Co. county well located Clay


LANDOWNER: Miss. Forestry Commission - Jackson  
(mailing address)

description of formations encountered	from	to
Top Soil	0	20
sandy shale	20	50
Sand	50	97
hard, lime stone	97	144
lime stone	144	568
shale	568	755
sandy shale	755	833
fine sand	833	844
shale	844	855
rocks	855	859
sandy shale	859	942
sandy shale rocks	942	986
shale rocks	986	1008
shale	1008	1096

WELL LOCATION:  
sec. 27 T. 15 N. R. 4 E  
8 miles (distance) S (direction) of Rehob (nearest town)

WELL PURPOSE: for town  
(home, irrigation, municipal, industrial)

- WELL COMPLETION DATA:
- (1) diameter (inches) 4"
  - (2) total depth (feet) 569
  - (3) static water level (feet) 320 <sup>below</sup>/<sub>above</sub> top of ground.
  - (4) casing st. 569  
(material) (depth)  
4"  
(size) If telescope see back.
  - (5) screen None  
(length) (depth to top)  
(size) (material)
  - (6) pump 1 7  
(HP) (yield gpm)  
electric  
(type power)
  - (7) electric log yes  
(yes or no)  
U. S. G. W.  
(organization running log)
  - (8) how well bottom plugged \_\_\_\_\_

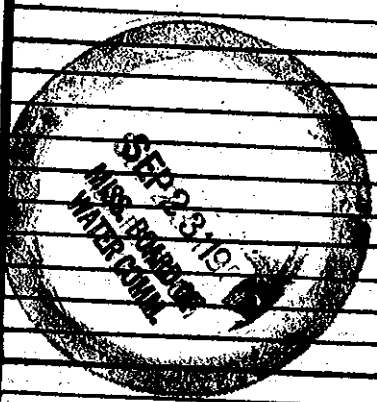

DRILLERS REMARKS: