

Clay
A 10
7-68

MISSISSIPPI
BOARD OF WATER COMMISSIONERS
416 North State Street
Jackson, Mississippi 39201

CODED

Water Well Drillers Supply, Inc.
P. O. Box 42
SHANNON, MISSISSIPPI 38888

7/8 1968 date well completed
firm name
Clay county well located

LANDOWNER:

Steve Watkins
P.O. Box 222, East Point, Miss
(mailing address)

description of formations encountered

Surface Sand
Clay
SAND
706

from

to

0 28
28 550
550 706

WELL LOCATION:

sec. 35 T 15 N R 4 E
6 miles E of Monticello
(distance) (direction) (nearest town)


WELL PURPOSE:

(home, irrigation, municipal, industrial)

WELL COMPLETION DATA:

- (1) diameter (inches) 5"
- (2) total depth (feet) 700'
- (3) static water level (feet) 198' below above top of ground.
- (4) casing (material) steel (depth) 33' 8"
- (size) if telescope see back.
- (5) screen (length) (depth to top)
- (size) (material)
- (6) pump 1/2 (HP) 3 (yield gpm)
electric (type power)
- (7) electric log (yes or no)
- (organization running log)
- (8) how well bottom plugged open

CODED

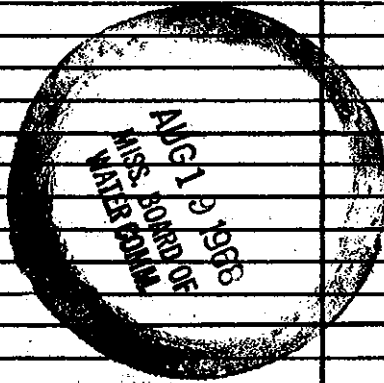

DRILLERS REMARKS: