

CLAY
 B ~~2000~~ 2000
 7-66

MISSISSIPPI BOARD OF WATER COMMISSIONERS

WATER WELL DRILLERS LOG

Date: July 15 1966, Driller: Horndon-Homan Well & Supply, Inc. County: Clay
(When well drilled) P. O. Box 42
SHANNON, MISSISSIPPI 38600 (Where well is located)


(1) Owner of Land: Boyd Burns
(Name)
Off 1 Prairie, Miss.
(Address)
 (2) Location: SE 1/4, SE 1/4, Sec. 6 T. 155 R. 5E
0 miles - of UNA
(distance) (direction) (Nearest Town)
 (3) Topography: flat
(Hilly) (Flat) (Level)
 (4) Purpose of Well: Home
(Domestic Irrigation Municipal, Industrial, Other)

Description & Color of Materials Sand, Clay, Red Clay, Shell, etc.	Thick- ness Feet	Depth Feet
<u>Surface mud & clay</u>	<u>0</u>	<u>20</u>
<u>Blue clay</u>	<u>20</u>	<u>40</u>
<u>Sand</u>	<u>480</u>	<u>600</u>
<u>Bottom</u>	<u>600</u>	

Information upon completion of well:

(1) Diameter 5 inches.
 (2) Total Depth 600 feet.
 (3) Water Level 80 feet below top of ground.
 (4) Cased to 24', Size 5"
 (5) Screen: Size None Length _____
 (6) Were any formations sealed against pollution?
 yes, no.

If YES depth of formation 20'
 Why Surface & sand
 Drillers Remarks: _____
 Yield in gpm: 5
 Size pump: 1/3
 Type power: Electric

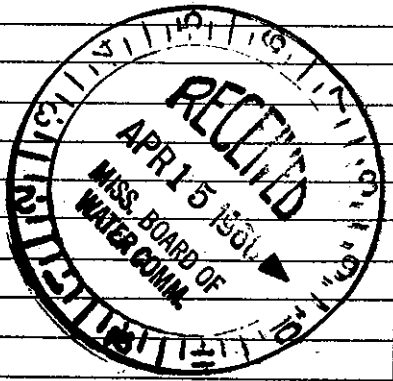

Mail this copy to Board of Water Commissioners 429 Miss. St. Jackson, Miss.