

CLAY
 B 2001
 5-67

MISSISSIPPI BOARD OF WATER COMMISSIONERS

WATER WELL DRILLERS LOG


Date: 5-3, 1967, Driller: Herndon-Homan Well & Supply, Inc.
 (When well drilled) P. O. Box 42 County CLAY
STANFORD, MISSISSIPPI 39088 (Where well is located)

(1) Owner of Land: John Townsend
 (Name)
RA 1 Prairie Miss
 (Address)
 (2) Location: NE 1/4, NE 1/4, Sec. 4 T15S R3E
1 miles NE of UNA
 (distance) (direction) (Nearest Town)
 (3) Topography: flat
 (Hilly) (Flat) (Level)
 (4) Purpose of Well: Home
 (Domestic Irrigation
 Municipal, Industrial, Other)

Description & Color of Materials Sand, Clay, Red Clay, Shell, etc.	Thick- ness Feet	Depth Feet
<u>uniform sand</u>	<u>0</u>	<u>20</u>
<u>& clay</u>	<u>20</u>	<u>40</u>
<u>blue clay</u>	<u>450</u>	<u>600</u>
<u>bottom</u>	<u>600</u>	

Information upon completion of well:

(1) Diameter 5 inches.
 (2) Total Depth 600 feet.
 (3) Water Level 110 feet below top of ground.
 (4) Cased to 22', Size 5"
 (5) Screen: Size none, Length _____
 (6) Were any formations sealed against pollution?
yes, _____ no.
 If YES depth of formation 20'
 Why surface & sand
 Drillers Remarks:
 Yield in gpm: 5
 Size pump: 1/3 HP sub.
 Type power: electric

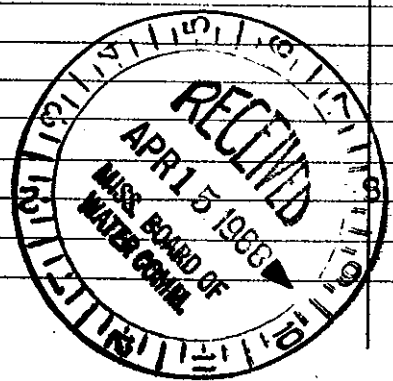

Retain this copy for your office files.