

Clay
B 2006
8-68

MISSISSIPPI
BOARD OF WATER COMMISSIONERS
416 North State Street
Jackson, Mississippi 39201

WATER WELL DRILLERS LOG

8-14 1968
date well completed
Shannon, Mississippi
firm: Shannon Well & Supply, Inc.
Box 42
County well located: Clay

LANDOWNER:

Coley Passon

At 1 Box 28, Prairie, Miss
(mailing address)

description of formations encountered

description of formations encountered	from	to
Surface sand	0	18
Blue clay	18	250
Sand	250	400
Bottom	400	

WELL LOCATION:


sec. 23 T. 15 N R. 5 E
3 miles SE of UNA
(distance) (direction) (nearest town)

WELL PURPOSE:

(home, irrigation, municipal, industrial)

WELL COMPLETION DATA:

- diameter (inches) 5"
- total depth (feet) 400'
- static water level (feet) 43 below top of ground.
- casing (material) steel (depth) 21'5"
(size) 5" if telescope see back.
- screen (length) NO (depth to top)
- pump (HP) HP (yield gpm)
- electric log (yes or no) NO
(organization running log)
- how well bottom plugged open

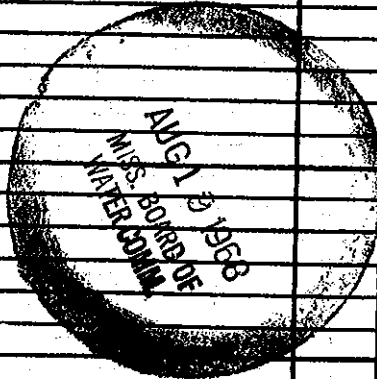

DRILLERS REMARKS: