

#2

MISSISSIPPI DEPARTMENT OF ENVIRONMENTAL QUALITY  
Bureau of Land and Water Resources

P. O. Box 10631  
Jackson, MS 39289-0631  
WATER WELL DRILLERS LOG

COUNTY WELL LOCATED <i>Clay</i>		PERMIT NUMBER
WELL NUMBER <i>C 25</i>	CODED <input checked="" type="checkbox"/>	NAME OF DRILLING FIRM <i>McDonald &amp; Hill</i>
DATE WELL COMPLETED <i>7/23/93</i>		<i>Meredian, Miss</i>

NAME & MAILING ADDRESS OF LANDOWNER <i>Prestage Farms</i>		
<i>P.O. Box 438</i>		
<i>Clinton, N.C. 28328</i>		
WELL LOCATION: SEC	TOWNSHIP	RANGE
<i>33</i>	<i>16 N</i>	<i>3 E</i>
DISTANCE <i>5</i> Miles	DIRECTION <i>NW</i>	NEAREST TOWN <i>Phelan</i>
OTHER LANDMARK		
WELL PURPOSE: Home, Irrigation, Municipal, Industrial, Fish Pond, etc. <i>Hog Pasture</i>		

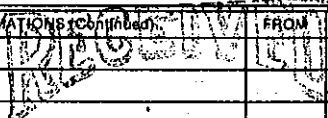
PUMP DATA		
PUMP TYPE (Circle One): <input checked="" type="checkbox"/> Submersible, Turbine, Jet, Flowing Well, Other (Describe)		
POWER TYPE (Circle One): <input checked="" type="checkbox"/> Electric, Tractor, Diesel, Gasoline, Butane, Other (Describe) H/P <i>5</i>		
Pump Capacity (GPM) <i>50</i>	No. of Stages <i>15</i>	Setting Depth <i>252</i> FT.
PUMP TEST		
Well yielded <i>20</i> GPM with a drawdown of <i>20</i> ft. after <i>1 hr.</i> hours of pumping		

Well Depth <i>1166</i>	Casing Diameter (In.) <i>4"</i>	Casing Length (Ft.) <i>810'</i>
Type of Casing <i>Steel</i>	Hole Depth <i>810'</i>	Depth to Static Water Level <i>140'</i>
TYPE OF COMPLETION: (Circle One or More): Gravel Packed, Underreamed, <input checked="" type="checkbox"/> Telescoped, Natural Development, Open Hole, Other (Describe)		
Top of Lap Pipe or Reduction in Casing FEET IF TELESCOPED OR MORE THAN ONE SCREEN: USE BACK PAGE		

LOG DATA	
TYPE OF LOG RUN (Circle One): <input type="checkbox"/> No Log Run, Electric, Gamma Ray, Density, Sonic, Neutron, Other (Describe)	
Name of Organization Running Log	

SCREEN DATA		
Diameter - Inches <i>2 1/2"</i>	Length - Feet <i>60'</i>	Slot Size - inches <i>20-70' 008-010</i>
Screen Type <i>Stainless Steel</i>	Depth to Bottom - Feet <i>1166</i>	

GEOLOGIC DATA (Office Use Only)			
Surface Elev.	Geologic Unit	Unit Thickness	Depth to Top
Subs. SWL	Date	Analysis	Aquifer Test
Driller's Remarks			

DESCRIPTION OF FORMATIONS ENCOUNTERED	FROM	TO	FORMATIONS (Continued)	FROM	TO
<i>Clay Sand</i>	<i>0</i>	<i>26</i>	 NOV 02 1993 Dept. of Environmental Quality Office of Land & Water Resources		
<i>Dark Shale</i>	<i>26</i>	<i>73</i>			
<i>Lime Rock</i>	<i>73</i>	<i>840</i>			
<i>Amie sand, Rocky shale</i>	<i>840</i>	<i>955</i>			
<i>Kandy Shale, Sand</i>	<i>955</i>	<i>1098</i>			
<i>Sand</i>	<i>1098</i>	<i>1166</i>			

IF MORE SPACE IS NEEDED, USE BACK