

CLAY
C 2000

MISSISSIPPI BOARD OF WATER COMMISSIONERS

10-20-62

WATER WELL DRILLERS LOG

HERNDON WELL & SUPPLY CO.

P. O. BOX 42

Date: Apr 20, 1962, Driller: HERNDON, MISSISSIPPI County: Clay
(Name)

(1) Owner of Land: <u>Walter Vallant</u> (Name)	Description & Color of Materials Sand, Clay, Red Clay, Shell, etc.	Thick- ness Feet	Depth Feet
<u>Marion, Miss</u> (Address)	<u>clay</u>		<u>0</u>
(2) Location: <u>36 155</u> <u>3</u> miles <u>E</u> of <u>Marion</u> (distance) (direction) (Nearest Town)	<u>Blue rock</u>		<u>30</u>
(3) Topography: <u>Hilly</u> (Hilly) (Flat) (Level)	<u>White sand</u>		<u>25</u>
(4) Purpose of Well: <u>Domestic</u> (Domestic Irrigation Municipal, Industrial, Other)	<u>Gumbo</u>		<u>80</u>


Information upon completion of well:

- (1) Diameter 4 inches.
- (2) Total Depth 1055 feet.
- (3) Water Level 175 feet below top of ground.
- (4) Cased to 805', Size 4" 2"
- (5) Screen: Size _____, Length _____
- (6) Were any formations sealed against pollution?
 yes, _____ no.

If YES depth of formation 250'

Why gumbo & sand

Drillers Remarks:

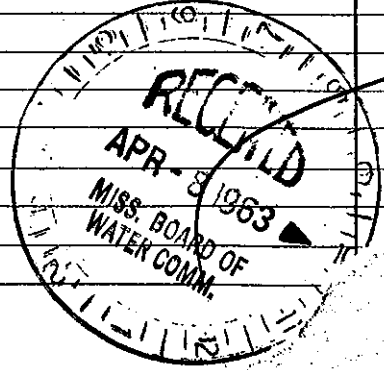

(Use Back)

Mail this copy to Board of Water Commissioners 429 Mis