

Clay
 E 2001
 7-68

MISSISSIPPI
 BOARD OF WATER COMMISSIONERS
 416 North State Street
 Jackson, Mississippi 39201

WATER WELL DRILLERS LOG

SEAMAN Well & Supply, Inc. Log
 P. O. Box 48
 SEAMAN, MISSISSIPPI 39288

July 19 68 date well completed
 county well located


LANDOWNER:
 Phillip Deady
 at Phebe Miss
 (mailing address)

description of formations encountered	from	to
Surface Sand	0	2.50
Clay	2.50	8.80
Sand	8.80	10.60
BTL	10.60	

WELL LOCATION:
 sec. 9 T. 16 N. R. 3 E
 S W
 1/2 miles NE of Pinebluff
 (distance) (direction) (nearest town)

WELL PURPOSE: Home
 (home, irrigation, municipal, industrial)

- WELL COMPLETION DATA:
- (1) diameter (inches) 4"
 - (2) total depth (feet) 1000'
 - (3) static water level (feet) 78' below top of ground.
 - (4) casing Steel 271' (material) (depth)
 4" (size) if telescope see back.
 - (5) screen 60' 937' (length) (depth to top)
 2" (size) slotted pipe (material)
 - (6) pump 1/2 (HP) 5 (yield gpm)
 electric (type power)
 - (7) electric log no (yes or no)
 (organization running log)
 - (8) how well bottom plugged plugged

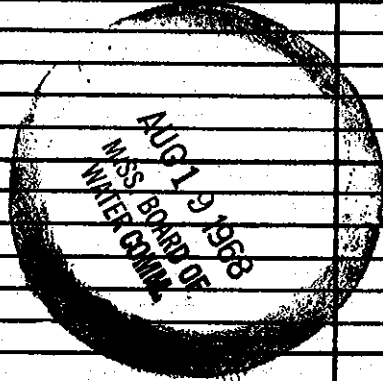

DRILLERS REMARKS: