

CLAY  
E 10  
7-9-60

MISSISSIPPI BOARD OF WATER COMMISSIONERS

WATER WELL DRILLERS LOG

Can't locate?


Date: July 9, 19 60, Driller: T. M. PARKS County CLAY

CODED

(Name)

	Description & Color of Materials Sand, Clay, Red Clay, Shell, etc.	Thick- ness Feet	Depth Feet
(1) Owner of Land: <u>Emmitt Downs</u> (Name) <u>West Point, Mississippi</u> (Address)	Clay sand and rock with clay	6 12	
(2) Location: <u>1/4, 22 165 SE</u> <u>9 miles Northwest, of West Point</u> (distance) (direction) (Nearest Town)	White formation with rocks and clay to Chalk formation to water sand Balance sand	50 540 125	
(3) Topography: <u>Flat</u> (Hilly) (Flat) (Level)			
(4) Purpose of Well: <u>Domestic</u> (Domestic Irrigation Municipal, Industrial, Other)			
Information upon completion of well:			
(1) Diameter <u>4</u> inches.			
(2) Total Depth <u>637</u> feet.			
(3) Water Level <u>80</u> feet below top of ground.			
(4) Cased to <u>63'6"</u> , Size <u>4 inch</u>			
(5) Screen: Size <u>None</u> , Length _____			
(6) Were any formations sealed against pollution? <u>X</u> yes, _____ no.			
If YES depth of formation <u>63'6"</u>			
Why _____			
Drillers Remarks: <u>Well was cased 63'6"</u> <u>to prevent penetration of pollution</u> <u>to well.</u>			

CODED

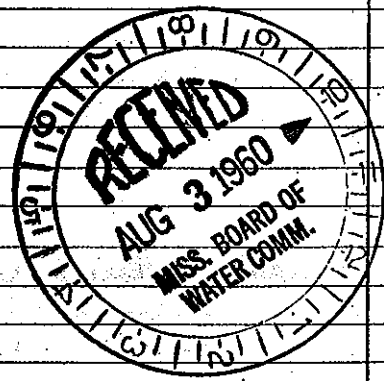

Well No.

(Use Back Side)

Mail this copy to Board of Water Commissioners 429 Miss. St. Jackson. Miss