

**CLAY**  
**F 26**  
**11/5/71**

MISSISSIPPI  
 BOARD OF WATER COMMISSIONERS **DEC 28 1971**  
 416 North State Street  
 Jackson, Mississippi 39201

WATER WELL DRILLERS LOG **CODED**  
 HERMAN ECHOLS

MISS. Bd. of  
 WATER COMMISSIONERS

**11/5** 19 **71**  
 Date well completed



Phone Well Service  
 Starkville, Miss. county well located

LANDOWNER:

**Mrs H.W. Gogay**  
**R.F.D. #1, P.O. #1, Gogay**  
 (mailing address)

Phone No. 323-5111  
 description of formations encountered

from to

<b>Sand &amp; Clay</b>	<b>0</b>	<b>30</b>
<b>Chalk</b>	<b>30</b>	<b>780</b>
<b>Sand &amp; Rock</b>	<b>780</b>	<b>900</b>

WELL LOCATION:


sec **9** T **20N** R **13E**  
**3** miles **North** of **P.O. #1**  
 (distance) (direction) (nearest town)

WELL PURPOSE: **Home**  
 (home, irrigation, municipal, industrial)

WELL COMPLETION DATA:

- diameter (inches) **5"**
- total depth (feet) **900'**
- static water level (feet) **140** below above top of ground.
- casing **5"** **42'**  
 (material) (depth)
- screen **100' slotted pipe**  
 (length) (depth to top)
- pump **3/4** **10**  
 (HP) (yield gpm)
- electric log (yes or no)

**CODED** "County"

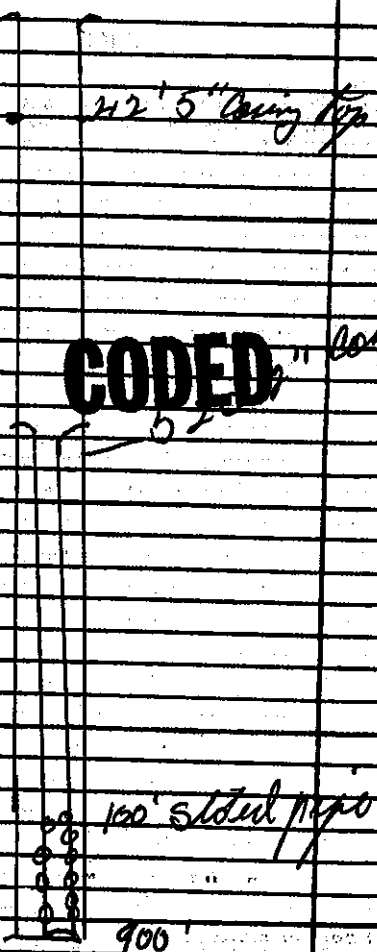

DRILLERS REMARKS: