

CLAY

MISSISSIPPI BOARD OF WATER COMMISSIONERS


F 2000

9-10-62

WATER WELL DRILLERS LOG

Date: Sept 10, 1962, Driller: HERNDON WELL & SUPPLY CO.
P. O. BOX 42 County Clay
SHANNON, MISSISSIPPI

(1) Owner of Land:	Description & Color of Materials Sand, Clay, Red Clay, Shell, etc.	Thick- ness Feet	Depth Feet
Mrs. <u>L. O. Cummings</u> (Name) <u>Pheba, Miss.</u> (Address)	clay		0
(2) Location: <u>1/4, 1/4, Sec 21 T 20N R 13E</u>	blue rock		9
<u>2</u> miles <u>NE</u> , of <u>Pheba</u> (distance) (direction) (Nearest Town)	blue rock		23
(3) Topography: <u>Flat</u> (Hilly) (Flat) (Level)	rock		138
(4) Purpose of Well: <u>Domestic</u> (Domestic Irrigation Municipal, Industrial, Other)	blue rock		139
Information upon completion of well:	rock		213
(1) Diameter <u>4</u> inches.	blue rock		214
(2) Total Depth <u>920</u> feet.	rock		220
(3) Water Level <u>100</u> feet below top of ground.	blue rock		221
(4) Cased to <u>267 ft</u> 4 in. Size <u>2 in.</u>	bambo		595
(5) Screen: Size <u>2 in</u> , Length <u>20 ft.</u>	rock		620
(6) Were any formations sealed against pollution? <input checked="" type="checkbox"/> yes, <input type="checkbox"/> no.	fine sand		621
If YES depth of formation	rock		770
Why <u>super sand</u>	sand		771
Drillers Remarks:	rock		795
	sand		810
	fine sand		900
	Bottom		920

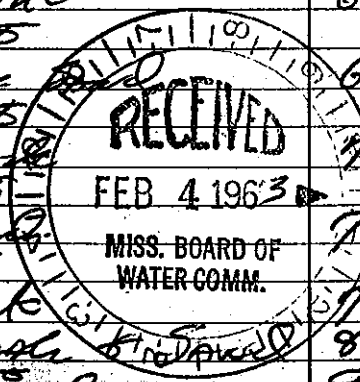

(Use Back Side)